

MISSISSIPPI DEPARTMENT OF NATURAL RESOURCES

Bureau of Land and Water Resources

Southport Mall

P.O. Box 10631

Jackson, Mississippi 39209

WATER WELL DRILLERS LOG

Marshall  
E 2065

HICKS WELL CO.

Pt 1 Box 157

Senatobia, MS 38650

Marshall

date well completed

8-4 19 82

county well located

LANDOWNER: <u>Edith M. Hicks</u>	description of formations encountered	from	to
<u>Beyhalia, Miss. 38611</u> (mailing address)	<u>Red clay</u>	<u>0</u>	<u>20</u>
	<u>Red sand</u>	<u>20</u>	<u>50</u>
WELL LOCATION: sec. <u>18</u> T. <u>2</u> N. R. <u>4</u> E. <u>4</u> miles <u>NE</u> of <u>Rubalia</u> (distance) (direction) (nearest town)	<u>White sand + clay</u>	<u>50</u>	<u>90</u>
	<u>White sand</u>	<u>90</u>	<u>125</u>
WELL PURPOSE: <u>Home</u> (home, irrigation, municipal, industrial)			
WELL COMPLETION DATA:			
(1) diameter (inches) <u>4</u>			
(2) total depth (feet) <u>125</u>			
(3) static water level (feet) <u>80</u> <u>below</u> top of ground.			
(4) casing <u>PVC</u> , <u>125</u> (material) (depth) <u>4"</u> (size) If telescope see back.			
(5) screen <u>10</u> , <u>115</u> (length) (depth to top) <u>013</u> , <u>PVC</u> (size) (material)			
(6) pump <u>1/2</u> , <u>10</u> (HP) (yield gpm) <u>220V</u> (type power)			
(7) electric log <u>No</u> (yes or no)			
(organization running log)			
(8) how well bottom plugged <u>Cap</u>			
DRILLERS REMARKS:			


DEPT. OF NATURAL RESOURCES  
BUREAU OF LAND & WATER RESOURCES

AUG 27 1982

RECEIVED

If well telescopes please sketch and show depths.

GROUND LEVEL

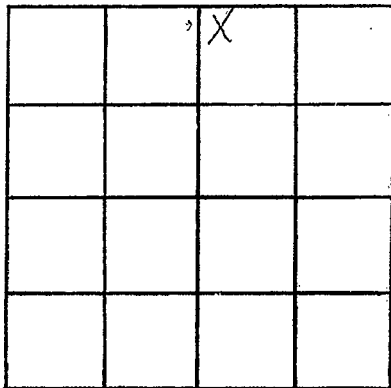

SECTION

18

Please indicate well location X.

ADDITIONAL INFORMATION

If more than one screen, show locations of each on sketch.