

MISSISSIPPI DEPARTMENT OF NATURAL RESOURCES

Bureau of Land and Water Resources

Southport Mall

P.O. Box 10631

Jackson, Mississippi 39209

WATER WELL DRILLERS LOG

HICKS WELL CO.  
Rt. 1, Box 157  
Senatobia, MS 38668

Marshall  
E  
2067

1-5 1983  
date well completed

Marshall  
county well located

LANDOWNER: C.W. Albright  
Rt. 1 Box 364  
Byhalia, Ms. 38611  
(mailing address)

description of formations encountered	from	to
<u>Red clay</u>	<u>0</u>	<u>20</u>
<u>Red sand</u>	<u>20</u>	<u>60</u>
<u>white sand</u>	<u>60</u>	<u>140</u>

WELL LOCATION:  
sec 19 T 2 N R 4 E  
2 1/2 miles NE of Byhalia  
(distance) (direction) (nearest town)

WELL PURPOSE: Home  
(home, irrigation, municipal, industrial)

- WELL COMPLETION DATA:
- (1) diameter (inches) 4
  - (2) total depth (feet) 140
  - (3) static water level (feet) 100 below above top of ground.
  - (4) casing PVC 140'  
(material) (depth)  
4"  
(size) If telescope see back.
  - (5) screen 10' 130'  
(length) (depth to top)  
813 PVC  
(size) (material)
  - (6) pump 1/2 10  
(HP) (yield gpm)  
220V  
(type power)
  - (7) electric log No  
(yes or no)

(organization running log)


(8) how well bottom plugged Cap

DRILLERS REMARKS:

DEPT. OF NATURAL RESOURCES  
BUREAU OF LAND & WATER RESOURCES  
FEB 22 1983  
RECEIVED

If well telescopes please sketch and show depths.

GROUND LEVEL

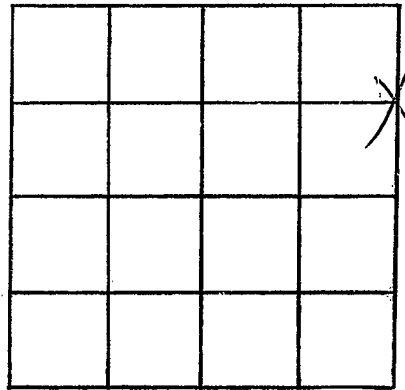

SECTION 19

Please indicate well location X.

ADDITIONAL INFORMATION

If more than one screen, show locations of each on sketch.