

MISSISSIPPI DEPARTMENT OF NATURAL RESOURCES

Bureau of Land and Water Resources

Southport Mall

P.O. Box 10631

Jackson, Mississippi 39209

WATER WELL DRILLERS LOG

Marshall  
E  
2068

4

date well completed 4-18 1983 firm name Mauser Houston Well Co county well located Marshall

LANDOWNER: Reggie Carab  
Rt 1 Box 410 CC 45  
Byhalia, Miss  
 (mailing address)

description of formations encountered	depth	
	from	to
<u>Brown Clay</u>	<u>0</u>	<u>10</u>
<u>Red Sand</u>	<u>10</u>	<u>40</u>
<u>White Sand</u>	<u>40</u>	<u>65</u>
<u>White Clay</u>	<u>65</u>	<u>90</u>
<u>White Sand</u>	<u>90</u>	<u>125</u>

WELL LOCATION:  
 sec. 27 T. 2 N. R. 4 E  
5 miles S of Coyle  
 (distance) (direction) (nearest town)

WELL PURPOSE:  
 (home, irrigation, municipal, industrial)

- WELL COMPLETION DATA:
- (1) diameter (inches) 4
  - (2) total depth (feet) 125
  - (3) static water level (feet) 65 below above top of ground.
  - (4) casing Photo 115  
 (material) (depth)
  - 4 If telescope see back.  
 (size)
  - (5) screen 10 115  
 (length) (depth to top)
  - 4 Photo  
 (size) (material)
  - (6) pump 1/2 10  
 (HP) (yield gpm)
  - Elect  
 (type power)
  - (7) electric log (yes or no) (no)

(organization running log)

(8) how well bottom plugged 44  
Wash Cap

DRILLERS REMARKS:


DEPT. OF NATURAL RESOURCES  
 BUREAU OF LAND & WATER RESOURCES

MAY 6 - 1983

RECEIVED

If well telescopes please sketch and show depths.

GROUND LEVEL

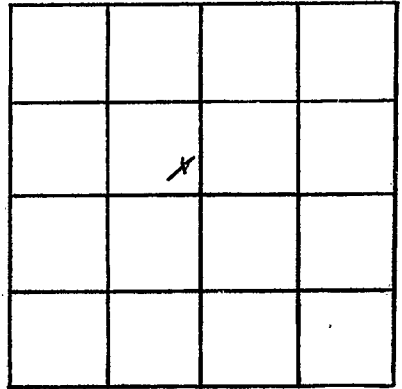

SECTION 27

Please indicate well location X.

ADDITIONAL INFORMATION

If more than one screen,  
show locations of each on sketch.