

**MARSHALL**

**E**

**2069**

**MISSISSIPPI DEPARTMENT OF NATURAL RESOURCES**

Bureau of Land and Water Resources

Southport Mall

P.O. Box 10631

Jackson, Mississippi 39209

**WATER WELL DRILLERS LOG**

**4-15-83**

**Harner Hunter Well Co**

**Marshall**

date well completed

firm name

county well located

LANDOWNER: **J.T. Spivey**

**Rt#1 Box 40 CC 105**

**Bykilia Miss**  
(mailing address)

description of formations encountered

from

to

**Brown Clay**

**0 15**

**Red Sand**

**15 25**

**White Sand**

**45 70**

**White Clay**

**70 75**

**White Sand**

**75 130**

WELL LOCATION:

sec. **26 T 2 N** R. **4 E**  
**5** miles **S** of **Cayce**  
(distance) (direction) (nearest town)

WELL PURPOSE:

~~Home~~ irrigation, municipal, industrial

WELL COMPLETION DATA:

(1) diameter (inches) **4**

(2) total depth (feet) **130**

(3) static water level (feet) **20** below above top of ground.

(4) casing **Plastic** **120**  
(material) (depth)

**4** if telescope see back.  
(size)

(5) screen **10** **120**  
(length) (depth to top)

**4** **Plastic**  
(size) (material)

(6) pump **1/2** **10**  
(HP) (yield gpm)

**Electric**  
(type power)

(7) electric log ~~(yes or no)~~

(organization running log)

(8) how well bottom plugged **4"**  
**Plastic Cap**

DRILLERS REMARKS:


DEPT. OF NATURAL RESOURCES  
BUREAU OF LAND & WATER RESOURCES

**MAY 6 - 1983**

**RECEIVED**

If well telescopes please sketch and show depths.

GROUND LEVEL

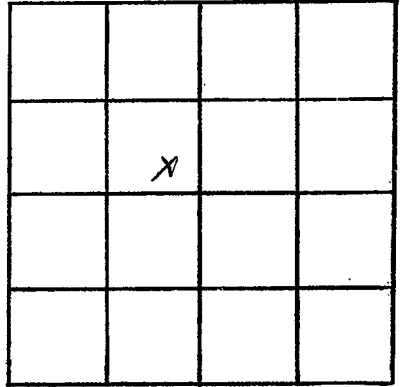

SECTION 26

Please indicate well location X.

ADDITIONAL INFORMATION

If more than one screen,  
show locations of each on sketch.