

MISSISSIPPI DEPARTMENT OF NATURAL RESOURCES

Bureau of Land and Water Resources

Southport Mall

P.O. Box 10631

Jackson, Mississippi 39209

WATER WELL DRILLERS LOG

MARSHALL
E
2070

4-15 1983 Lane Houts Marshall
date well completed firm name county well located

LANDOWNER: John Stout
Rt 1 Box 110 CC 104
Byhalta Miss
(mailing address)

description of formations encountered	from	to
<u>beacon clay</u>	<u>0</u>	<u>15</u>
<u>Red Sand</u>	<u>15</u>	<u>45</u>
<u>White Sand</u>	<u>45</u>	<u>70</u>
<u>White Clay</u>	<u>70</u>	<u>75</u>
<u>White Sand</u>	<u>75</u>	<u>130</u>

WELL LOCATION:
sec. 26 T. 2 N. R. 4 E
5 miles S of Cayle
(distance) (direction) (nearest town)

WELL PURPOSE:
(home, irrigation, municipal, industrial)

WELL COMPLETION DATA:

- (1) diameter (inches) 4
- (2) total depth (feet) 130
- (3) static water level (feet) 70 below above top of ground.
- (4) casing Plastic 120
(material) (depth)
4 if telescope see back.
(size)
- (5) screen 10 120
(length) (depth to top)
4 Plastic
(size) (material)
- (6) pump 70 10
(HP) (yield gpm)
slant
(type power)
- (7) electric log (yes or no)
(organization running log)
- (8) how well bottom plugged 4"
Plastic Cap

DRILLERS REMARKS:


DEPT. OF NATURAL RESOURCES
BUREAU OF LAND & WATER RESOURCES

MAY 6 - 1983

RECEIVED

If well telescopes please sketch and show depths.

GROUND LEVEL

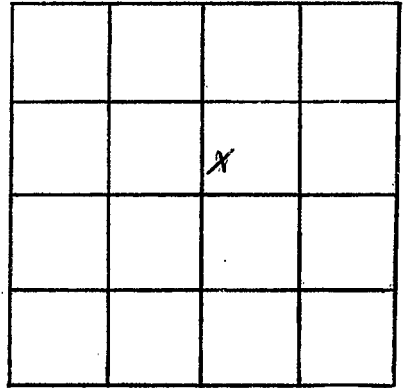

SECTION 26

Please indicate well location X.

ADDITIONAL INFORMATION

If more than one screen,
show locations of each on sketch.