

MISSISSIPPI DEPARTMENT OF NATURAL RESOURCES

Bureau of Land and Water Resources

Southport Mall

P.O. Box 10631

Jackson, Mississippi 39209

WATER WELL DRILLERS LOG

Marshall  
E  
2071

9-15-1984  
 date well completed

HICKS WELL CO.  
 P.O. Box 137  
 Senatobia, MS 38669

Marshall  
 county well located

LANDOWNER: Howard T. Hale

description of formations encountered	from	to
Red Clay	0	5
Red Sand	5	30
White Clay & Sand	30	60
White Sand	60	140
White Clay	140	170

Rt. 3  
Byhalis, Mo. 38611  
 (mailing address)

WELL LOCATION:  
 sec. 27 T 2 N R 4 E  
3 miles N of Victoria  
 (distance) (direction) (nearest town)

WELL PURPOSE: Home  
 (home, irrigation, municipal, industrial)

- WELL COMPLETION DATA:
- (1) diameter (inches) 4
  - (2) total depth (feet) 170
  - (3) static water level (feet) 150 <sup>below</sup> ~~above~~ top of ground.
  - (4) casing PVC 170  
 (material) (depth)  
4"  
 (size) if telescope see back.
  - (5) screen 10' 130'  
 (length) (depth to top)  
3/8" PVC  
 (size) (material)
  - (6) pump 1/2 10  
 (HP) (yield gpm)  
220V  
 (type power)
  - (7) electric log No  
 (yes or no)
  - (organization running log)
  - (8) how well bottom plugged Cap

DRILLERS REMARKS:


DEPT. OF NATURAL RESOURCES  
 BUREAU OF LAND & WATER RESOURCES

SEP 24 1984

RECEIVED

If well telescopes please sketch and show depths.

GROUND LEVEL

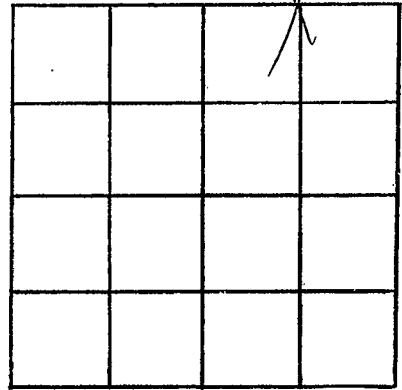

SECTION 27

Please indicate well location X.

ADDITIONAL INFORMATION

If more than one screen,  
show locations of each on sketch.