

MISSISSIPPI DEPARTMENT OF NATURAL RESOURCES

Bureau of Land and Water Resources

Southport Mall

P.O. Box 10631

Jackson, Mississippi 39209

WATER WELL DRILLERS LOG

Marshall
E
2072

HICKS WELL CO.
P.O. Box 157

Sendville, MS 38668

Marshall

9-18 1984
date well completed

county well located

LANDOWNER: Virgil Baker

description of formations encountered

from to

Rt. 3

Red Clay

0 15

~~Byrd~~ Byrd Ms. 38611
(mailing address)

Red Sand

15 60

WELL LOCATION:

sec. 22 T 2 N R 4 E
⑤ ①

White Sand + Clay

60 130

2 1/2 miles N of Victoria
(distance) (direction) (nearest town)

white sand

130 155

WELL PURPOSE: None
(home, irrigation, municipal, industrial)

WELL COMPLETION DATA:

- (1) diameter (inches) 4
- (2) total depth (feet) 155
- (3) static water level (feet) 100 below above top of ground.
- (4) casing PVC, 155
(material), (depth)
4"
(size) if telescope see back.
- (5) screen 10', 145'
(length), (depth to top)
1 1/2 PVC
(size), (material)
- (6) pump 1/2, 10
(HP), (yield gpm)
220V
(type power)
- (7) electric log Y
(yes or no)

(organization running log)

(8) how well bottom plugged CAP

DRILLERS REMARKS:


DEPT. OF NATURAL RESOURCES
BUREAU OF LAND & WATER RESOURCES

SEP 24 1984

RECEIVED

If well telescopes please sketch and show depths.

GROUND LEVEL

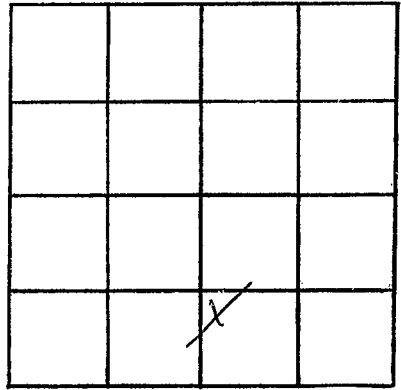

SECTION 27

Please indicate well location X.

ADDITIONAL INFORMATION

If more than one screen,
show locations of each on sketch.