

**MISSISSIPPI DEPARTMENT OF NATURAL RESOURCES**  
 Bureau of Land and Water Resources  
 Southport Mall  
 P.O. Box 10631  
 Jackson, Mississippi 39209  
**WATER WELL DRILLERS LOG**

E 2013  
Marshall

date well completed 3-6 19 85  
 firm name LUCKS WELL CO  
 P.O. Box 157

Marshall  
 county well located

LANDOWNER: Melvin Swang  
Pl. 1  
Bayou, Ms. 37611  
 (mailing address)

description of formations encountered	from	to
<u>Red Clay</u>	<u>0</u>	<u>10</u>
<u>Red Sand</u>	<u>10</u>	<u>30</u>

WELL LOCATION:  
 sec. 27 T 2 N R 4 E  
3 miles N of Victoria  
 (distance) (direction) (nearest town)

<u>White sand</u>	<u>30</u>	<u>130</u>
-------------------	-----------	------------

WELL PURPOSE: Home  
 (home, irrigation, municipal, industrial)

**WELL COMPLETION DATA:**

- (1) diameter (inches) 4
- (2) total depth (feet) 130
- (3) static water level (feet) 80 <sup>below</sup> above top of ground.
- (4) casing PVC 130  
 (material) (depth)  
4"  
 (size) if telescope see back.
- (5) screen 10' 120'  
 (length) (depth to top)  
1.010 PVC  
 (size) (material)
- (6) pump 1/2 10  
 (HP) (yield gpm)  
220V  
 (type power)
- (7) electric log No  
 (yes or no)  
 (organization running log)
- (8) how well bottom plugged Clay


DRILLERS REMARKS:

**RECEIVED**  
 MAR 14 1985

Department of Natural Resources  
 Bureau of Land & Water

If well telescopes please sketch and show depths.

GROUND LEVEL

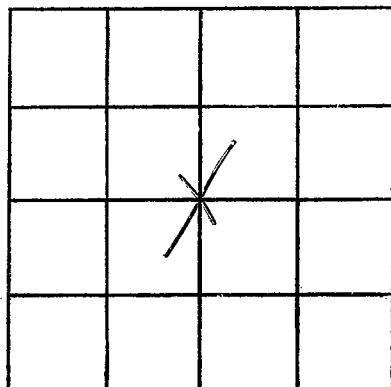

SECTION 27

Please indicate well location X.

ADDITIONAL INFORMATION

If more than one screen,  
show locations of each on sketch.