

**MISSISSIPPI DEPARTMENT OF NATURAL RESOURCES**  
**Bureau of Land and Water Resources**  
 Southport Mall  
 P.O. Box 10631  
 Jackson, Mississippi 39209  
**WATER WELL DRILLERS LOG**

MARSHALL  
E  
2074

date well completed 11-6 1985 **HICKS WELL COMPANY** Marshall  
 RT. 1 mi. 0.5 W 57 county well located

LANDOWNER: Margaret U. Wood

SENATUBIA, MISS.  
 description of formations encountered

1206 Sadron Circle  
Memphis TN 38111  
 (mailing address)

	from	to
Red clay	0	10
Red sand	10	30
White sand	30	125

WELL LOCATION:  
 sec. 26 T. 2 N. R. 4 E  
                   S                  W  
4 miles N of Vicksburg  
 (distance) (direction) (nearest town)

WELL PURPOSE: None  
 (home, irrigation, municipal, industrial)

- WELL COMPLETION DATA:
- (1) diameter (inches) 4"
  - (2) total depth (feet) 125'
  - (3) static water level (feet) 80' below above top of ground.
  - (4) casing PVC, 115'  
 (material) (depth)  
4" If telescope see back.  
 (size)
  - (5) screen 10', 115'  
 (length) (depth to top)  
0.13, PVC  
 (size) (material)
  - (6) pump 1/2, 10  
 (HP) (yield gpm)  
220 V  
 (type power)
  - (7) electric log NO  
 (yes or no)

(organization running log)

(8) how well bottom plugged Cop


DRILLERS REMARKS:

**RECEIVED**  
**DEC 16 1985**

Department of Natural Resources  
 Bureau of Land & Water

If well telescopes please sketch and show depths.

GROUND LEVEL

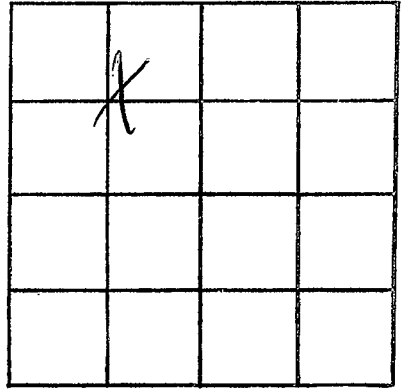

SECTION 26

Please indicate well location X.

ADDITIONAL INFORMATION

If more than one screen,  
show locations of each on sketch.