

MISSISSIPPI DEPARTMENT OF NATURAL RESOURCES

Bureau of Land and Water Resources

Southport Mall

P.O. Box 10631

Jackson, Mississippi 39209

WATER WELL DRILLERS LOG

<i>Marshall</i>
<i>E</i>
<i>2077</i>

3-24 19 *86 Larry Carpenter Well Co.* *Marshall*
 date well completed firm name county well located

LANDOWNER: *G.W. Stewart*
Bygdalia, ms.
RFD
 (mailing address)


description of formations encountered	from	to
<i>Med. Red Sand</i>	<i>0</i>	<i>30</i>
<i>White Clay</i>	<i>30</i>	<i>48</i>
<i>Med. White Sand</i>	<i>48</i>	<i>60</i>
<i>White Clay</i>	<i>60</i>	<i>75</i>
<i>White coarse Sand</i>	<i>75</i>	<i>108</i>

WELL LOCATION:
 sec. *3* T. *2* N R. *4* E
 S W
1 miles *South* of *Coyne*
 (distance) (direction) (nearest town)

WELL PURPOSE: *Home*
 (home, irrigation, municipal, industrial)

WELL COMPLETION DATA:

- (1) diameter (inches) *4*
- (2) total depth (feet) *108*
- (3) static water level (feet) *50* below top of ground.
- (4) casing *PVC*, *98'*
 (material) (depth)
 (size) if telescope see back.
- (5) screen *10'*, *98'*
 (length) (depth to top)
4", *PVC*
 (size) (material)
- (6) pump *1* (HP) *20* (yield gpm)
Elec
 (type power)
- (7) electric log *no* (yes or no)
 (organization running log)
- (8) how well bottom plugged *PVC Cap*

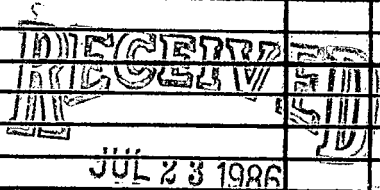


Department of Natural Resources
 Bureau of Land & Water

DRILLERS REMARKS:

If well telescopes please sketch and show depths.

GROUND LEVEL

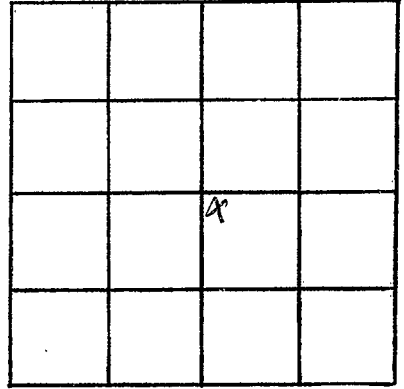

SECTION 3

Please indicate well location X.

ADDITIONAL INFORMATION

If more than one screen,
show locations of each on sketch.