

MISSISSIPPI DEPARTMENT OF NATURAL RESOURCES
Bureau of Land and Water Resources
 Southport Mall
 P.O. Box 10631
 Jackson, Mississippi 39209
WATER WELL DRILLERS LOG

MARSHALL
E
2078

5-20 1986 Larry Carpenter Willcox Marshall
 date well completed firm name county well located

LANDOWNER: Willcox Walker
Victoria, ms.
RFD
 (mailing address)

description of formations encountered	from	to
<u>Surface Soil</u>	<u>0</u>	<u>10</u>
<u>med. Red Sand</u>	<u>10</u>	<u>42</u>
<u>med. white sand</u>	<u>42</u>	<u>80</u>
<u>White coarse sand</u>	<u>80</u>	<u>104</u>
<u>white clay</u>	<u>104</u>	<u>170</u>
<u>White coarse sand</u>	<u>170</u>	<u>140</u>


WELL LOCATION:
 sec. 27 T 2 N R 4 E
 S W
3 miles north of Victoria
 (distance) (direction) (nearest town)

WELL PURPOSE:
 (home, irrigation, municipal, industrial)

WELL COMPLETION DATA:

- diameter (inches) 4
- total depth (feet) 140
- static water level (feet) 30 below above top of ground.
- casing PVC, 130'
 (material) (depth)
 (size) If telescope see back.
- screen 10', 130'
 (length) (depth to top)
4", PVC
 (size) (material)
- pump 1/2, 10
 (HP) (yield gpm)
Electric
 (type power)
- electric log no
 (yes or no)
 (organization running log)
- how well bottom plugged PVC cap

DRILLERS REMARKS:

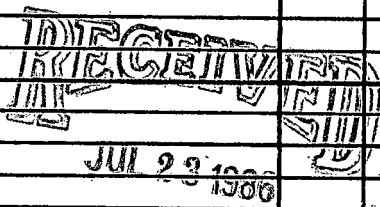

Department of Natural Resources
 Bureau of Land and Water Resources

If well telescopes please
sketch and show depths.

GROUND LEVEL

		4	

SECTION 27

Please indicate well location X.

ADDITIONAL INFORMATION

If more than one screen,
show locations of each on sketch.