

MISSISSIPPI DEPARTMENT OF ENVIRONMENTAL QUALITY
Bureau of Land and Water Resources

P. O. Box 10631
Jackson, MS 39289-0631
WATER WELL DRILLERS LOG

COUNTY WELL LOCATED MARSHALL	
WELL NUMBER E 2091	CODED
DATE WELL COMPLETED 4-6-92	

PERMIT NUMBER
NAME OF DRILLING FIRM HICKS WELL CO.
RT 1 BOX 157
SENATOBIA, MS 38668

NAME & MAILING ADDRESS OF LANDOWNER Royce Mays		
RT 1 Box 449F Byhalia		
MS 38668		
WELL LOCATION: SEC	TOWNSHIP	RANGE
34	2	4
DISTANCE	DIRECTION	NEAREST TOWN
8 Miles	W	Holly Springs
OTHER LANDMARK		
WELL PURPOSE: <input checked="" type="checkbox"/> Home, <input type="checkbox"/> Irrigation, <input type="checkbox"/> Municipal, <input type="checkbox"/> Industrial, <input type="checkbox"/> Fish Pond, etc.		

PUMP DATA		
PUMP TYPE (Circle One): <input checked="" type="checkbox"/> Submersible, <input type="checkbox"/> Turbine, <input type="checkbox"/> Jet, <input type="checkbox"/> Flowing Well, Other (Describe) _____		
POWER TYPE (Circle One): <input checked="" type="checkbox"/> Electric, <input type="checkbox"/> Tractor, <input type="checkbox"/> Diesel, <input type="checkbox"/> Gasoline, <input type="checkbox"/> Butane, Other (Describe) _____ H/P 1/2		
Pump Capacity (GPM) 10	No. of Stages	Setting Depth 150 FT.
PUMP TEST		
Well yielded 10 GPM with a drawdown of _____ ft. after _____ hours of pumping		

WELL DATA		
Well Depth 180	Casing Diameter (In.) 4"	Casing Length (Ft.) 170
Type of Casing PVC	Hole Depth 180	Depth to Static Water Level 135
TYPE OF COMPLETION: (Circle One or More): <input checked="" type="checkbox"/> Gravel Packed, <input type="checkbox"/> Underreamed, <input type="checkbox"/> Telescoped, <input type="checkbox"/> Natural Development, <input type="checkbox"/> Open Hole, <input type="checkbox"/> Other		
Top of Lap Pipe or Reduction in Casing		
FEET		
IF TELESCOPED OR MORE THAN ONE SCREEN: USE BACK PAGE		

LOG DATA	
TYPE OF LOG RUN (Circle One): <input type="checkbox"/> No Log Run, <input type="checkbox"/> Electric, <input type="checkbox"/> Gamma Ray, <input type="checkbox"/> Density, <input type="checkbox"/> Sonic, <input type="checkbox"/> Neutron, Other (Describe) _____	
Name of Organization Running Log	

SCREEN DATA		
Diameter - Inches 4"	Length - Feet 10'	Slot Size - Inches 013
Screen Type PVC	Depth to Bottom - Feet 10'	

GEOLOGIC DATA (Office Use Only)			
Surface Elev.	Geologic Unit	Unit Thickness	Depth to Top
Subs. SWL	Date	Analysis	Aquifer Test
Driller's Remarks			


DESCRIPTION OF FORMATIONS ENCOUNTERED	FROM	TO
CLAY	0	30
Rock	30	35
CLAY	35	125
white sand	125	180

FORMATIONS (Continued)	FROM	TO
RECEIVED		
JUN 10 1992		
Dept. of Environmental Quality		
Bureau of Land & Water Resources		

IF MORE SPACE IS NEEDED, USE BACK

If well telescopes please
sketch and show depths.

GROUND LEVEL

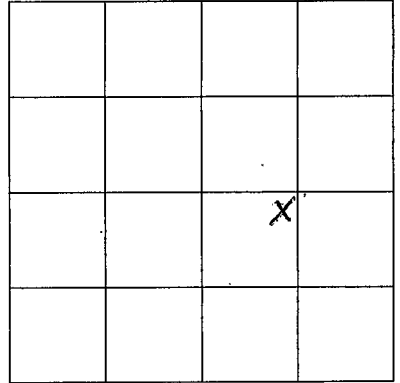

SECTION _____

Please indicate well location X.

ADDITIONAL INFORMATION

If more than one screen,
show location of each on sketch.