

15E

CODED

MARSHALL

F I

10-29-68

MISSISSIPPI
 BOARD OF WATER COMMISSIONERS
 416 North State Street
 Jackson, Mississippi 39201

WATER WELL DRILLERS LOG

10-29-68 19
date well completed

Atkinson & Frost
firm name

Marshall
county well located

LANDOWNER:

Robert LEE Penitton

Lamar Miss
(mailing address)

Description of formations encountered

from to

Red Sand	0	50
White Sand	57	13.5

WELL LOCATION:

sec 2 T 1 N R 3 E
 5 miles SW of Slayden
 (distance) (direction) (nearest town)

WELL PURPOSE:

(home, irrigation, municipal, industrial)

WELL COMPLETION DATA:

- (1) diameter (inches) 4 1/2
- (2) total depth (feet)
- (3) static water level (feet) 100 below top of ground
- (4) casing (material) (depth) (size) if telescope see back.
- (5) screen (length) (depth to top) (size) (material)
- (6) pump (HP) (yield gpm) (type power) Elec
- (7) electric log (yes or no) (organization running log)
- (8) how well bottom plugged

CODED

JAN 27 1969


MISS. Bd. of WATER COMMISSIONERS

DRILLERS REMARKS

See Log

If well telescopes please sketch and show depths.

GROUND LEVEL

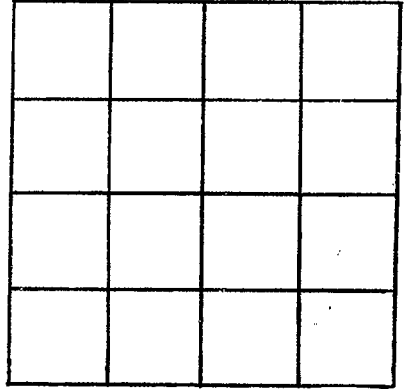

SECTION _____

Please indicate well location X.

ADDITIONAL INFORMATION

If more than one screen, show locations of each on sketch.