

MASSHALL

F2

10-3-68

MISSISSIPPI
 BOARD OF WATER COMMISSIONERS
 416 North State Street
 Jackson, Mississippi 39201

CODED

CODED

WATER WELL DRILLERS LOG

Oct 3 1968 - Dimpas well Co - Marshall
 date well completed firm name county well located

LANDOWNER:

Marcel Chilton
 Rt 4 Hall Springs Miss.
 (mailing address)

description of formations encountered

from

to

Clay zone

0 20
20 210

WELL LOCATION:

sec. 22 T 2 N R 3 E
 S W
 4 miles South of Mt. Pleasant
 (distance) (direction) (nearest town)

WELL PURPOSE:

(home, irrigation, municipal, industrial)

WELL COMPLETION DATA:

- (1) diameter (inches) 4"
- (2) total depth (feet) 210
- (3) static water level (feet) 155 below top of ground.
- (4) casing 4" gal. 203 (material) (depth)

(size) If telescope see back.

- (5) screen 7' 203 (length) (depth to top)

4" x 7' sand gravel wall (size) (material)

- (6) pump 3/4 10 gal (HP) (yield gpm)

Belco (type power)

- (7) electric log (yes or no)

(organization running log)

- (8) how well bottom plugged 4" Cap


DRILLERS REMARKS:

FEB 17 1968

MISS. BD. OF WATER COMMISSIONERS

If well telescopes please sketch and show depths.

GROUND LEVEL

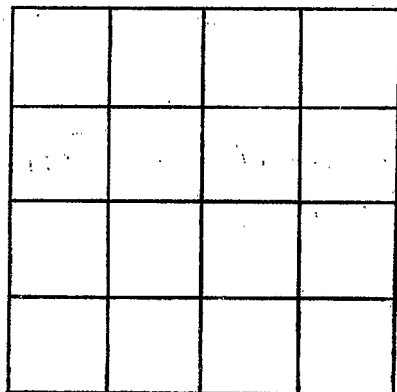

SECTION _____

Please indicate well location X.

ADDITIONAL INFORMATION

If more than one screen, show locations of each on sketch.