

CODED

Marshall  
73  
3-14-69

MISSISSIPPI  
BOARD OF WATER COMMISSIONERS  
416 North State Street  
Jackson, Mississippi 39201

WATER WELL DRILLERS LOG

March 14 1969 Earl Jones Well Co Marshall  
date well completed firm name county well located

LANDOWNER: Robert Moore  
Red Banks, RT 1  
(mailing address)

description of formations encountered	from	to
Top soil	0	10
sand	10	126

WELL LOCATION:  
sec. 8 T 2 N R 3 E  
2 1/2 miles S W. of Mt Pleasant  
(distance) (direction) (nearest town)

WELL PURPOSE: home  
(home, irrigation, municipal, industrial)

- WELL COMPLETION DATA:
- (1) diameter (inches) 2
  - (2) total depth (feet) 126
  - (3) static water level (feet) 85 below above top of ground.
  - (4) casing Plastic, 120ft.  
(material) (depth)
  - (size) if telescope see back.
  - (5) screen 6ft. 120ft.  
(length) (depth to top)
  - 2 in coarse plastic-gravel  
(size) (material)
  - (6) pump 3/4 HP 4  
(HP) (yield gpm)
  - Electric  
(type power)
  - (7) electric log no.  
(yes or no)
  - (organization running log)
  - (8) how well bottom plugged back shot

CODED


APP  
MAY 1969

DRILLERS REMARKS:

MISSISSIPPI  
BOARD OF WATER COMMISSIONERS

If well telescopes please sketch and show depths.

GROUND LEVEL

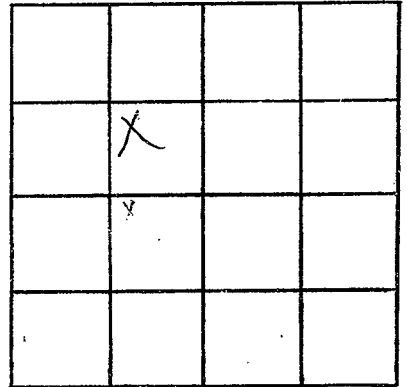

SECTION 8

Please indicate well location X.

ADDITIONAL INFORMATION

If more than one screen, show locations of each on sketch.