

Marshall
F 8
1-27-70

MISSISSIPPI
BOARD OF WATER COMMISSIONERS
416 North State Street
Jackson, Mississippi 39201

WATER WELL DRILLERS LOG

CODED
Marshall

1-27 19 70 Bumpax Well Co firm name
date well completed county well located

LANDOWNER:
Frank Feathers
Healy Springs, Miss
R.F. #
(mailing address)

WELL LOCATION:
sec. 22 T 2 N R 3 E
3 miles South of Mt. Pleasant
(distance) (direction) (nearest town)

WELL PURPOSE:
(home, irrigation, municipal, industrial)

WELL COMPLETION DATA:

(1) diameter (inches) 4"

(2) total depth (feet) 220 feet

(3) static water level (feet) 165 feet below top of ground.

(4) casing PVC, 220 feet (material) (depth)

(size) if telescope see back.

(5) screen 6 ft, 214 feet (length) (depth to top)

4", gravel wall (size) (material)

(6) pump 3/4, 10 (HP) (yield gpm)

(type power)

(7) electric log elect. (yes or no)

(organization running log)

(8) how well bottom plugged 4" cap.

| description of formations encountered | from | to |
|---------------------------------------|------------|------------|
| <u>clay</u> | <u>0</u> | <u>20</u> |
| <u>Sand</u> | <u>20</u> | <u>80</u> |
| <u>clay</u> | <u>80</u> | <u>110</u> |
| <u>Sand</u> | <u>110</u> | <u>220</u> |


DRILLERS REMARKS:

MAR 6 - 1970

MISS. BD. OF
WATER COMM.

If well telescopes please sketch and show depths.

GROUND LEVEL

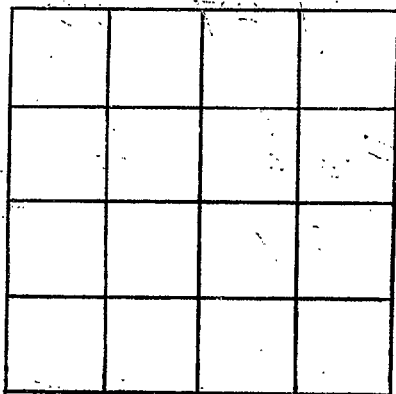

SECTION _____

Please indicate well location X.

ADDITIONAL INFORMATION

If more than one screen,
show locations of each on sketch.