

Marshall  
F 9  
2-11-70

MISSISSIPPI  
BOARD OF WATER COMMISSIONERS  
416 North State Street  
Jackson, Mississippi 39201

**CODED**

WATER WELL DRILLERS LOG

Feb. 11 1970 B. L. Carpenter Marshall  
date well completed firm name county well located

LANDOWNER:	description of formations encountered	from	to
M. A. McClure			
Red Bank, Miss	Surface Soil	0	21
RFD	med white sand	0	44
(mailing address)	Coarse white sand	44	83
WELL LOCATION:	white clay	83	98
sec. 18 T. 2 N. R. 3 E	white coarse sand	98	138
3 1/2 miles South of Mt. Pleasant			
(distance) (direction) (nearest town)			
WELL PURPOSE: Home			
(home, irrigation, municipal, industrial)			
WELL COMPLETION DATA:			
(1) diameter (inches) 4			
(2) total depth (feet) 138			
(3) static water level (feet) 90 below top of ground.			
(4) casing Plastic, 132 ft. (material) (depth)			
(size) if telescope see back.			
(5) screen 6 ft., 132 ft. (length) (depth to top)			
1/2 in. Plastic & gravel (size) (material)			
(6) pump 1/2 7 (HP) (yield gpm)			
Elec. (type power)			
(7) electric log no (yes or no)			
(organization running log)			
(8) how well bottom plugged Plastic Plug			

**CODED**

MAR 10 1970


MISS. BD. OF  
WATER COMM.

DRILLERS REMARKS:

If well telescopes please sketch and show depths.

GROUND LEVEL

R3.6

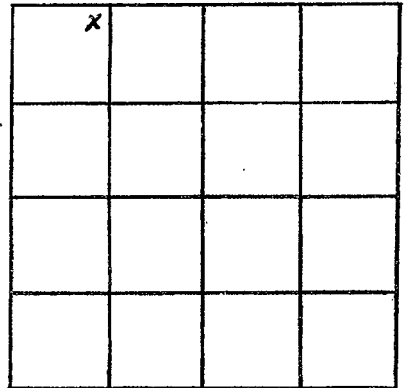

SECTION 18

Please indicate well location X.

ADDITIONAL INFORMATION

If more than one screen, show locations of each on sketch.