

MISSISSIPPI
BOARD OF WATER COMMISSIONERS
416 North State Street
Jackson, Mississippi 39201

CODED

WATER WELL DRILLERS LOG

Marshall
F 12
8-29-70

Aug 29 1970 Earl Jones Well Co. Marshall
date well completed firm name county well located

LANDOWNER:
Jessie McKinney
Holly Springs Miss. RT 4
(mailing address)

WELL LOCATION:
sec. 14 T. 2 N R. 3 E
1/2 miles SE of Mt Pleasant
(distance) (direction) (nearest town)

WELL PURPOSE: Home
(home, irrigation, municipal, industrial)

- WELL COMPLETION DATA:
- (1) diameter (inches) 2"
 - (2) total depth (feet) 146'
 - (3) static water level (feet) 118 below above top of ground.
 - (4) casing plastic 140'
(material) (depth)
2"
(size) if telescope see back.
 - (5) screen 6' 140'
(length) (depth to top)
2"
(size) plastic filler pipe
(material)
 - (6) pump 1 3
(HP) (yield gpm)
Electric
(type power)
 - (7) electric log no
(yes or no)

description of formations encountered	depth	
	from	to
Top soil + clay	0	10
sand	0	16
clay	16	30
sand & clay mixed	30	45
sand	45	100
clay	100	110
sand	110	146

CODED

(organization running log)

SEP 23 1970


(8) how well bottom plugged
plastic cap

MISS. BD. OF
WATER COM.

DRILLERS REMARKS:

If well telescopes please sketch and show depths.

GROUND LEVEL

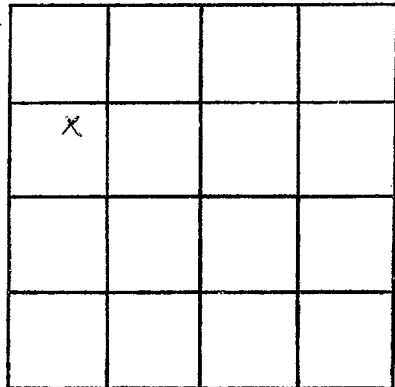

SECTION 14

Please indicate well location X.

ADDITIONAL INFORMATION

If more than one screen, show locations of each on sketch.