

Marshall
F 13
4-3-70

MISSISSIPPI
BOARD OF WATER COMMISSIONERS
416 North State Street
Jackson, Mississippi 39201

CODED

WATER WELL DRILLERS LOG

April 3 1970 R. L. Capata Marshall
date well completed firm name county well located

LANDOWNER: Aubrey Bolton

Holly Springs
P.O. R.F.D.
(mailing address)

description of formations encountered

from to

Surface Soil	0	13
Fire Red Sand	13	35
red white sand	35	52
white clay	52	95
White Coarse Sand	95	127
white clay	127	145
white coarse sand	145	170

WELL LOCATION:

sec. 15 T. 2 N. R. 3 E
3 1/2 miles South of Wallowa
(distance) (direction) (nearest town)

WELL PURPOSE:

Home (home, irrigation, municipal, industrial)

WELL COMPLETION DATA:

- (1) diameter (inches) 4
- (2) total depth (feet) 170
- (3) static water level (feet) 1.35 below top of ground
- (4) casing (material) Plastic, 164 ft (depth)
- (size) if telescope see back.
- (5) screen 6 ft, 164 ft (length) (depth to top)
- Hex. Plated Steel (size) (material)
- (6) pump 3/4 10 (HP) (yield gpm)
- Elec. (type power)
- (7) electric log no (yes or no)

(organization running log)

Plastic Plog

(8) how well bottom plugged

CODED

JUL 13 1970

MISS. DEPT. OF WATER CONTROL


DRILLERS REMARKS:

If well telescopes please sketch and show depths.

GROUND LEVEL

R3W.

T25

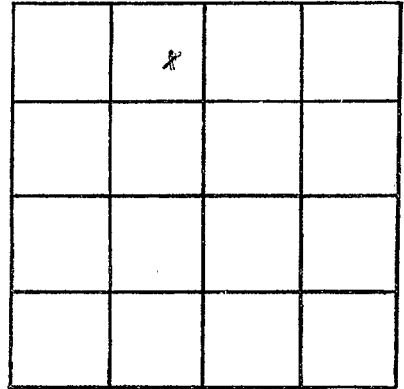

SECTION 15

Please indicate well location X.

ADDITIONAL INFORMATION

If more than one screen, show locations of each on sketch.