

MARSHALL

F14

7-21-70

MISSISSIPPI
 BOARD OF WATER COMMISSIONERS
 416 North State Street
 Jackson, Mississippi 39201

CODED

WATER WELL DRILLERS LOG

July 21 1970

Bumpas Well Co.

Marshall

date well completed

firm name

county well located

LANDOWNER:

James W. Smith
 Rt 4 Holly Springs, Miss
 (mailing address)

description of formations encountered

from

to

Clay
 Sand
 Clay
 Sand

0 20
 20 80
 80 140
 140 200

WELL LOCATION:

sec. 15 T 2 N R 3 E
 3 miles South of Mt. Pleasant
 (distance) (direction) (nearest town)

WELL PURPOSE:

Domestic (home, irrigation, municipal, industrial)

WELL COMPLETION DATA:

- (1) diameter (inches) 4"
- (2) total depth (feet) 200 feet
- (3) static water level (feet) 150 ft below top of ground.
- (4) casing PVC 200 feet (material) (depth)
- (size) If telescope see back.
- (5) screen 6 ft 19 1/2 ft (length) (depth to top)
- 4" Small well (size) (material)
- (6) pump 3/4 HP 10 (HP) (yield gpm)
- (type power)
- (7) electric log elect (yes or no)
- (organization running log)

CODED

- (8) how well bottom plugged 4" Cop


AUG 12 1970

DRILLERS REMARKS:

MISS. BD. OF WATER COM.

If well telescopes please sketch and show depths.

GROUND LEVEL

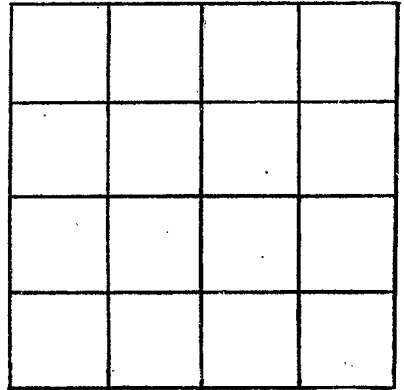

SECTION _____

Please indicate well location X.

ADDITIONAL INFORMATION

If more than one screen, show locations of each on sketch.