

MISSISSIPPI
BOARD OF WATER COMMISSIONERS
416 North State Street
Jackson, Mississippi 39201

CODED

MARSHALL
F17
2-24-71

WATER WELL DRILLERS LOG

2-24-71 date well completed *Bumpass Well Co.* firm name *Marshall* county well located

Holly Springs, Miss.

LANDOWNER:
M. J. Panson

description of formations encountered

	from	to
<i>clay</i>	<i>0</i>	<i>20</i>
<i>Sand</i>	<i>20</i>	<i>60</i>
<i>clay</i>	<i>60</i>	<i>100</i>
<i>Sand</i>	<i>100</i>	<i>170</i>

Holly Springs, Miss.
Rt 4. (mailing address)

WELL LOCATION:
sec. 23 T. 2 N. R. 3 E
9 miles South of H.S.
(distance) (direction) (nearest town)

WELL PURPOSE: *Drinking*
(home, irrigation, municipal, industrial)

WELL COMPLETION DATA:

(1) diameter (inches) 4"

(2) total depth (feet) 170 feet

(3) static water level (feet) 10 feet below top of ground.

(4) casing PVC (material), 170 feet (depth)
(size) If telescope see back.

(5) screen 6 feet (length), 16.4 feet (depth to top)
4" (size), gravel (material)

(6) pump 1/2 (HP), 8 (yield gpm)
(type power)

(7) electric log elect. (yes or no)
(organization running log)

(8) how well bottom plugged 4" cap

CODED


MAR 8 1971

DRILLERS REMARKS:

MISS. BU. OF
GEOL. & WATER RES.

If well telescopes please sketch and show depths.

GROUND LEVEL

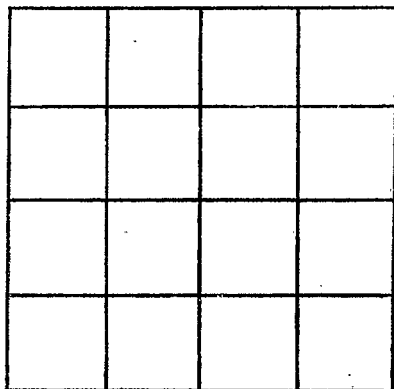

SECTION _____

Please indicate well location X.

ADDITIONAL INFORMATION

If more than one screen,
show locations of each on sketch.