

**MARSHALL**  
**F18**  
**3-18-71**

MISSISSIPPI  
 BOARD OF WATER COMMISSIONERS  
 416 North State Street  
 Jackson, Mississippi 39201

**CODED**

**WATER WELL DRILLERS LOG**

March 18 1971 Earl Jones Well Co Marshall  
 date well completed firm name county well located

LANDOWNER:  
John Gatewood  
Holly Springs Miss RT 4  
 (mailing address)

description of formations encountered	depth	
	from	to
<del>Clay</del> Clay & Topsoil	0	20
Sand	20	65
Clay & Sand mixed	65	105
Sand	105	145

WELL LOCATION:  
 sec 14 T 2 N R 3 E  
4 miles S.E. of MT Pleasant  
 (distance) (direction) (nearest town)

WELL PURPOSE: Home  
 (home, irrigation, municipal, industrial)

WELL COMPLETION DATA:

(1) diameter (inches) 2"

(2) total depth (feet) 145'

(3) static water level (feet) \_\_\_\_\_ below/above top of ground.

(4) casing Plastic 139'  
 (material) (depth)  
2" if telescope see back.  
 (size)

(5) screen 6' 139'  
 (length) (depth to top)  
2" Plastic Filter Pipe  
 (size) (material)

(6) pump 1 \_\_\_\_\_  
 (HP) (yield gpm)  
Electric  
 (type power)

(7) electric log No  
 (yes or no)

(8) how well bottom plugged \_\_\_\_\_  
Plastic log

**CODED**


APR 19 1971

MISS. BD. OF  
 WATER COMM.

DRILLERS REMARKS:

If well telescopes please sketch and show depths.

GROUND LEVEL

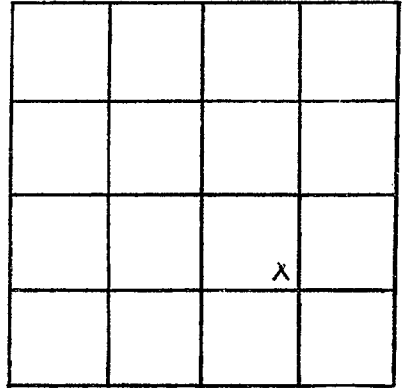

SECTION 14

Please indicate well location X.

ADDITIONAL INFORMATION

If more than one screen, show locations of each on sketch.