

**MARSHALL**  
**F 19**  
**4-2-71**

MISSISSIPPI  
 BOARD OF WATER COMMISSIONERS  
 416 North State Street  
 Jackson, Mississippi 39201

**CODED**

**WATER WELL DRILLERS LOG**

date well completed 4-7-71 19 71 Bumpas Well Co. Marshall  
 firm name county well located  
Neart Rent Bumpas

LANDOWNER:  
Paul Geogor  
Holly Springs, Miss.  
 (mailing address)

WELL LOCATION:  
 sec. 20 T 2 N R 3 E  
13 miles NORTH WEST of Holly Springs  
 (distance) (direction) (nearest town)

WELL PURPOSE: Drilling  
 (home, irrigation, municipal, industrial)

WELL COMPLETION DATA:

(1) diameter (inches) 4"

(2) total depth (feet) 190 feet

(3) static water level (feet) 100 below above top of ground.

(4) casing PVC 190 feet  
 (material) (depth)  
 (size) if telescope see back.

(5) screen 6 ft 18 4 ft  
 (length) (depth to top)  
4" gravel w/lf  
 (size) (material)

(6) pump 3/4 10  
 (HP) (yield gpm)  
 (type power)

(7) electric log elect.  
 (yes or no)  
 (organization running log)

(8) how well bottom plugged 4" conf.

description of formations encountered	from	to
<u>clay</u>	<u>0</u>	<u>20</u>
<u>sand</u>	<u>20</u>	<u>150</u>
<u>clay</u>	<u>150</u>	<u>160</u>
<u>sand</u>	<u>160</u>	<u>190</u>

**CODED**


APR 19 1971

MISS. BD. OF  
 WATER CONTROL

DRILLERS REMARKS:

If well telescopes please sketch and show depths.

GROUND LEVEL

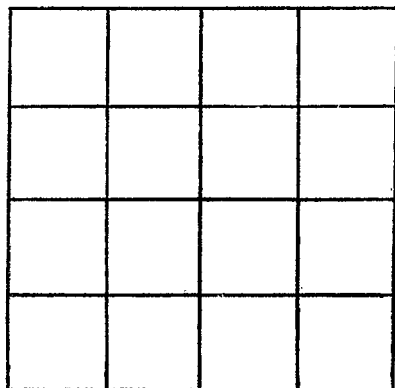

SECTION \_\_\_\_\_

Please indicate well location X.

ADDITIONAL INFORMATION

If more than one screen,  
show locations of each on sketch.