

MARSHALL
F20
2-20-71

MISSISSIPPI
BOARD OF WATER COMMISSIONERS
416 North State Street
Jackson, Mississippi 39201

CODED

WATER WELL DRILLERS LOG

Feb 20 1971 R. L. Carpenter Marshall
date well completed firm name county well located

LANDOWNER: Donnie Trone
Red Banks, RFD
Miss.
(mailing address)

WELL LOCATION:
sec. 8 T 2 N R 3 E
2 miles Southwest of Millbrook
(distance) (direction) (nearest town)

WELL PURPOSE: Home
(home, irrigation, municipal, industrial)

WELL COMPLETION DATA:

- (1) diameter (inches) 4
- (2) total depth (feet) 127
- (3) static water level (feet) 71 below above top of ground.
- (4) casing Plastic, 121 ft.
(material) (depth)
(size) If telescope see back.
- (5) screen 6 ft., 121 ft.
(length) (depth to top)
4 in., Plastic & Sand
(size) (material)
- (6) pump 3/4 10
(HP) (yield gpm)
Elec.
(type power)
- (7) electric log No
(yes or no)

(organization running log)

- (8) how well bottom plugged Plastic Plug

description of formations encountered	from	to
Surface Soil	0	15
Med. Red Sand	15	36
med white sand	36	61
Coarse white sand	61	80
white clay	80	86
med white sand	86	102
Coarse white sand	102	127

CODED


MAY 3 1971

DRILLERS REMARKS:

MISS. BD. OF
WATER COMM.

If well telescopes please sketch and show depths.

GROUND LEVEL

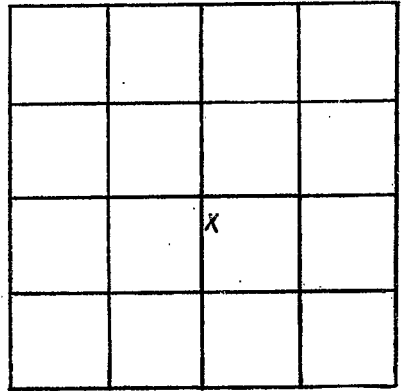

SECTION 8

Please indicate well location X.

ADDITIONAL INFORMATION

If more than one screen,
show locations of each on sketch.