

MARSHALL

F-21
6-5-62

Date: 6-5, 1962, Driller: Adam Bros. Co. Inc. County Marshall

(Name)

CODED

(1) Owner of Land: Julian Joyner
(Name)
Vally Springs Rte 4
(Address)

(2) Location: 1/4, 1/4, Sec. 5 2 3 T. R.
_____ miles _____ of _____
(distance) (direction) (Nearest Town)

(3) Topography: _____
(Hilly) (Flat) (Level)

(4) Purpose of Well: _____
(Domestic Irrigation
Municipal, Industrial, Other)

Description & Color of Materials Sand, Clay, Red Clay, Shell, etc.	Thick- ness Feet	Depth Feet
top soil	0-20	
coarse white sand	20-30	
fine white sand	30-60	
fine sand + white clay	60-100	
fine sand	100-140	
medium white sand	140-160	
coarse sand	160-180	

Information upon completion of well:

(1) Diameter 4 inches.

(2) Total Depth 180 feet.

(3) Water Level 125 feet below top of ground.

(4) Cased to 166, Size _____

(5) Screen: Size 4", Length 14'


(6) Were any formations sealed against pollution?
_____ yes, _____ no.

If YES depth of formation _____

Why _____

Drillers Remarks: _____

CODED

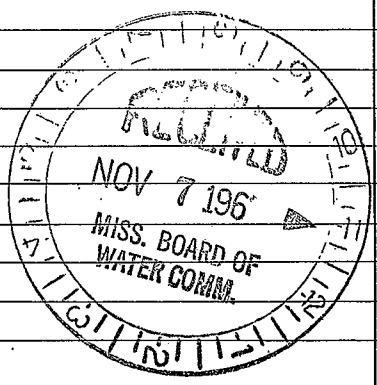

(Use Back Side)

Well No.

