

**CODED**

**WATER WELL DRILLERS LOG**

F 22  
2-25-64

Date: 2-25, 1964, Driller: obco of Independence County Marshall  
(Name)

(1) Owner of Land: Jim MacClure  
(Name)  
Slaydon  
(Address)

(2) Location: 12 23  
\_\_\_\_\_ 1/4, \_\_\_\_\_ 1/4, Sec. \_\_\_\_\_ T R \_\_\_\_\_  
\_\_\_\_\_ miles \_\_\_\_\_ of \_\_\_\_\_  
(distance) (direction) (Nearest Town)

(3) Topography: \_\_\_\_\_  
(Hilly) (Flat) (Level)

(4) Purpose of Well: \_\_\_\_\_  
(Domestic Irrigation  
Municipal, Industrial, Other)

Description & Color of Materials Sand, Clay, Red Clay, Shell, etc.	Thick- ness Feet	Depth Feet
<u>top soil</u>	<u>0</u>	<u>20</u>
<u>red sand + clay</u>	<u>20</u>	<u>40</u>
<u>white clay</u>	<u>40</u>	<u>70</u>
<u>white fine sand</u>	<u>70</u>	<u>120</u>
<u>medium coarse</u>		
<u>white sand</u>	<u>120</u>	<u>140</u>

Information upon completion of well:

(1) Diameter 4 inches.

(2) Total Depth 140 feet.

(3) Water Level 110 feet below top of ground.

(4) Cased to 133, Size \_\_\_\_\_


(5) Screen: Size 4", Length 7'

(6) Were any formations sealed against pollution?  
\_\_\_\_\_ yes, \_\_\_\_\_ no.

**CODED**

If YES depth of formation \_\_\_\_\_  
Why \_\_\_\_\_

Drillers Remarks: \_\_\_\_\_

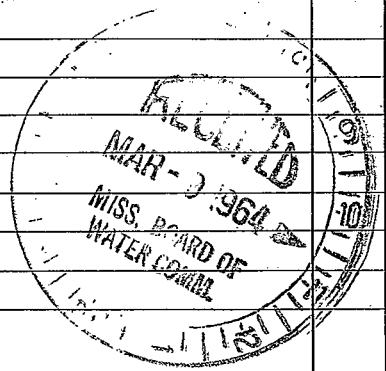

(Use Back Side)

Well No.

100