

MARSHALL

F-23

5-12-71

MISSISSIPPI BOARD OF WATER COMMISSIONERS
416 North State Street
Jackson, Mississippi 39201

WATER WELL DRILLERS LOG

CODED

May 12 1971
date well completed

R. L. Caperton
firm name

county well located

LANDOWNER: E. D. West & Son

Red Banks

Miss. RFD

(mailing address)

description of formations encountered

from to

surface soil 0 18

med. white sand 18 47

white clay 47 60

white coarse sand 60 81

white clay 81 87

white coarse sand 87 127

WELL LOCATION:

sec. 7 T 4 N R 3 E

4 miles Southwest of North
(distance) (direction) (nearest town)

WELL PURPOSE: farm
(home, irrigation, municipal, industrial)

WELL COMPLETION DATA:

(1) diameter (inches) 4

(2) total depth (feet) 127

(3) static water level (feet) 68 below top of ground.

(4) casing Plastic, 115 ft
(material) (depth)

(size) If telescope see back.

(5) screen 12, 115 ft
(length) (depth to top)

4 in., Plastic Band
(size) (material)

(6) pump 3, 60
(HP) (yield gpm)

Elec.
(type power)

(7) electric log no
(yes or no)

(organization running log)

(8) how well bottom plugged Plastic cap


SEP 2 1971

DRILLERS REMARKS:

MISS. Bd. OF WATER COMM.

If well telescopes please sketch and show depths.

GROUND LEVEL

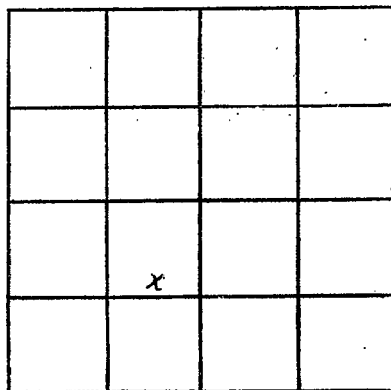

SECTION 2

Please indicate well location X.

ADDITIONAL INFORMATION

If more than one screen,
show locations of each on sketch.