

MARSHALL
F-24
5-22-71

MISSISSIPPI
 BOARD OF WATER COMMISSIONERS
 416 North State Street
 Jackson, Mississippi 39201

CODED

WATER WELL DRILLERS LOG

May 22 1971 R. L. Carpenter Marshall
 date well completed firm name county well located

LANDOWNER: James Cotton
Holly Springs
Miss. RFD
 (mailing address)

description of formations encountered	from	to
Surface Soil	0	14
med. red sand	14	35
fine white sand	35	68
white clay	68	95
med white sand	95	135
white coarse sand	135	160

WELL LOCATION:
 sec. 15 T 2 N R 3 E
3 miles South of Atkinson
 (distance) (direction) (nearest town)

WELL PURPOSE: Home
 (home, irrigation, municipal, industrial)

- WELL COMPLETION DATA:
- (1) diameter (inches) 4
 - (2) total depth (feet) 160
 - (3) static water level (feet) 122 below top of ground.
 - (4) casing Plastic, 154ft.
 (material) (depth)
 (size) if telescope see back.
 - (5) screen 6ft., 154ft.
 (length) (depth to top)
Fin. Plastic & Gravel
 (size) (material)
 - (6) pump 3/4 10
 (HP) (yield gpm)
1hp.
 (type power)
 - (7) electric log No
 (yes or no)
- (organization running log)
- (8) how well bottom plugged Plastic Plug


DRILLERS REMARKS:

SEP 2 1971

MISS. Bd. of
 WATER COMMISSIONERS

If well telescopes please sketch and show depths.

GROUND LEVEL

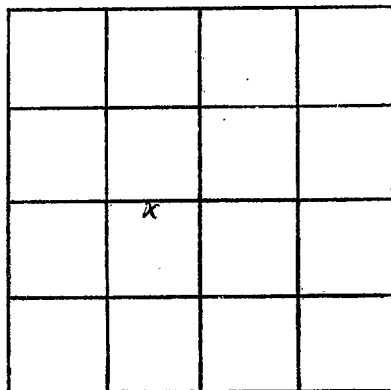

SECTION 15

Please indicate well location X.

ADDITIONAL INFORMATION

If more than one screen,
show locations of each on sketch.