

F26  
6-66

WATER WELL DRILLERS LOG **CODED**

Date: June 30, 1966, Driller: Larry Carpenter County Marshall  
(Name)

(1) Owner of Land: Cory Chapel Church  
(Name)  
Mt. Pleasant, Miss.  
(Address)

(2) Location: 1/4, 1/4, Sec. 22 T25R3E  
3 miles South, of Mt. Pleasant  
(distance) (direction) (Nearest Town)

(3) Topography: Hilly  
(Hilly) (Flat) (Level)

(4) Purpose of Well: Church  
(Domestic Irrigation  
Municipal, Industrial, Other)

Description & Color of Materials Sand, Clay, Red Clay, Shell, etc.	Thick- ness Feet	Depth Feet
<u>Surface Soil</u>	<u>17</u>	<u>17</u>
<u>Red coarse sand</u>	<u>23</u>	<u>40</u>
<u>from 17 ft to</u> <u>40 ft.</u>		
<u>medium white</u>	<u>58</u>	<u>98</u>
<u>sand from 40</u> <u>to 98 ft.</u>		
<u>White coarse</u>	<u>58</u>	<u>156</u>
<u>and fine sand</u> <u>mixed from 98</u> <u>ft. to 156 ft.</u>		
<u>Medium white</u>	<u>14</u>	<u>170</u>
<u>sand from 156</u> <u>to 170 ft.</u>		

Information upon completion of well:

(1) Diameter 4 inches.

(2) Total Depth 169 feet.

(3) Water Level 100 feet below top of ground.

(4) Cased to 162, Size 4 in.


(5) Screen: Size 4 in., Length 7 ft.

(6) Were any formations sealed against pollution?  
no

If YES depth of formation \_\_\_\_\_

Why \_\_\_\_\_

Drillers Remarks: \_\_\_\_\_

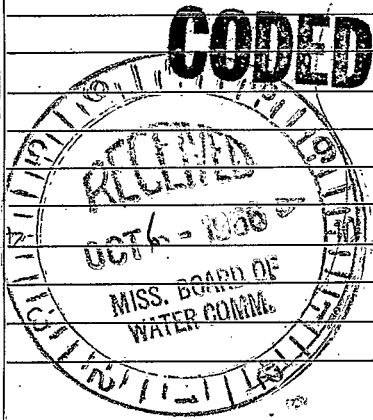

(Use Back Side)

Well No.

Handwritten notes at the top of the page, including a date and possibly a name.

Main body of handwritten text, appearing to be a list or series of entries.

Handwritten notes on the right side of the page, possibly serving as a sidebar or additional commentary.