

Marshall

F32 MISSISSIPPI BOARD OF WATER COMMISSIONERS

11-66

WATER WELL DRILLERS LOG

**CODED**

Date: Nov. 23, 1966, Driller: Larry Carpenter County Marshall  
(When well drilled) (Name) (Where well is located)

(1) Owner of Land: Jacob Hogan  
(Name)  
Holly Springs, Miss. RFD.  
(Address)

(2) Location: NE 1/4, SW 1/4, Sec. 12 T25R34W  
3 1/2 miles Southeast of St. Pleasant, Miss.  
(distance) (direction) (Nearest Town)

(3) Topography: Hilly  
(Hilly) (Flat) (Level)

(4) Purpose of Well: Resident  
(Domestic Irrigation  
Municipal, Industrial, Other)

Description & Color of Materials Sand, Clay, Red Clay, Shell, etc.	Thick- ness Feet	Depth Feet
Surface Soil	12	12
Red sand & clay	8	20
Red sand - medium	20	40
White clay	28	68
White sand coarse	37	105
White clay	4	109
Red & white coarse sand mixed	34	143
White clay	7	150
Fine white sand & white clay mixed	50	200
White coarse sand	23	223

Information upon completion of well:

(1) Diameter 4 inches.

(2) Total Depth 223 feet.

(3) Water Level 100 feet below top of  
ground. 216ft.

(4) Cased to , Size 4 in.

(5) Screen: Size 4 in., Length 7 ft.

(6) Were any formations sealed against pollution?  
\_\_\_\_\_ yes, X no.

If YES depth of formation \_\_\_\_\_


Why \_\_\_\_\_

Drillers Remarks: \_\_\_\_\_

Yield in gpm: Ten

Size pump: 3/4 H.P. - Submersible pump

Type power: Elec. 220 volts

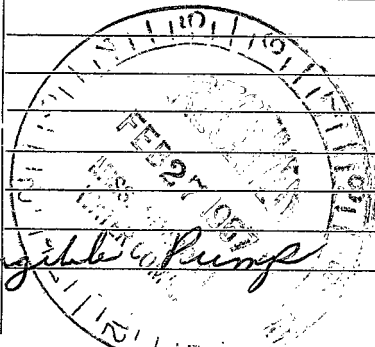

108

[The remainder of the page contains extremely faint and illegible text, likely bleed-through from the reverse side of the document.]