

Marshall
F34
5-67

MISSISSIPPI
BOARD OF WATER COMMISSIONERS
416 North State Street
Jackson, Mississippi 39201

CODED

WATER WELL DRILLERS LOG

May 20 1967 R. L. Carpenter Marshall
date well completed firm name county well located

LANDOWNER: Philip Row
Mt. Pleasant,
Miss.
(mailing address)

description of formations encountered	from	to
Surface Soil	0	17

WELL LOCATION:
sec. 4 T. 2 N R. 3 E
1 miles South, Mt. Pleasant
(distance) (direction) (nearest town)

Med. Red Sand	17	48
Yellow Clay	48	53

WELL PURPOSE: Resident
(home, irrigation, municipal, industrial)

Coarse white sand	53	98
-------------------	----	----

WELL COMPLETION DATA:
(1) diameter (inches) 4 in.
(2) total depth (feet) 160
(3) static water level (feet) 80 below top of ground.
(4) casing Plastic, 148 (material) (depth)
(size) if telescope see back.

White Clay	98	110
------------	----	-----

(5) screen 12 ft., 148 (length) (depth to top)
4 in., Plastic & Steel (size) (material)

Med white sand	110	135
----------------	-----	-----

(6) pump 3 (HP) 50 (yield gpm)
Elec. (type power)

Coars white sand	135	160
------------------	-----	-----


(7) electric log No (yes or no)

(organization running log)

(8) how well bottom plugged Plastic Plug

DRILLERS REMARKS:

CODED

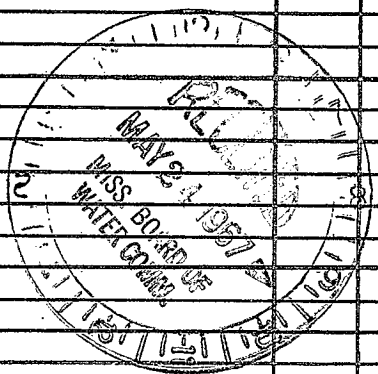

If well telescopes please sketch and show depths.

GROUND LEVEL

R 3 W

		X	

725

SECTION 4

Please indicate well location X.

ADDITIONAL INFORMATION

If more than one screen, show locations of each on sketch.