

Marshall
 735
 9-67

MISSISSIPPI
 BOARD OF WATER COMMISSIONERS
 416 North State Street
 Jackson, Mississippi 39201 **CODED**

WATER WELL DRILLERS LOG

Sept. 18 1967 R.L. Carpenter Marshall
 date well completed firm name county well located

LANDOWNER: Wayne Briscoe
 Red Banks,
 Miss.
 (mailing address)

Description of formations encountered	from	to
Surface Soil	0	14
Coarse Red sand	14	39
Coarse white sand	39	76
White Clay	76	89
White fine sand	89	143
Coarse white sand	143	157


WELL LOCATION:
 sec. 30 T. 2 N. R. 3 E.
 3 1/2 miles North of Red Banks
 (distance) (direction) (nearest town)

WELL PURPOSE: Farm
 (home, irrigation, municipal, industrial)

WELL COMPLETION DATA:

- (1) diameter (inches) 2 in
- (2) total depth (feet) 157
- (3) static water level (feet) 80 below top of ground.
- (4) casing Steel, 152 (material) (depth)
 (size) if telescope see back.
- (5) screen 5 ft., 152 ft. (length) (depth to top)
 4 in. Plastic Hard (size) (material)
 6 in. shock Red Pump
- (6) pump 1 H.P. motor, 3 (HP) (yield gpm)
 Elec (type power)
- (7) electric log no (yes or no)
 (organization running log)
- (8) how well bottom plugged Plastic Plug

CODED

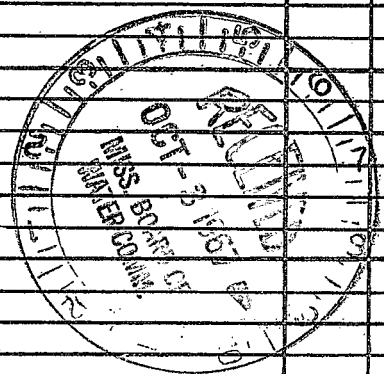


DRILLERS REMARKS:

If well telescopes please sketch and show depths.

GROUND LEVEL

R3W

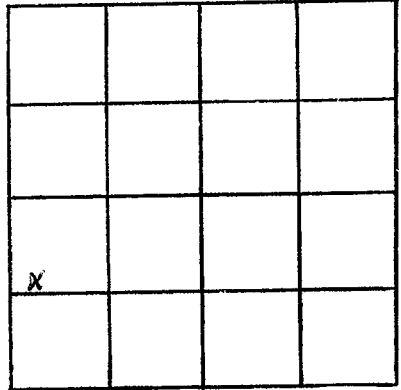

T25

X

SECTION 30

Please indicate well location X.

ADDITIONAL INFORMATION

If more than one screen, show locations of each on sketch.