

Marshall
 736
 4-16-68

MISSISSIPPI
 BOARD OF WATER COMMISSIONERS
 416 North State Street
 Jackson, Mississippi 39201

CODED

WATER WELL DRILLERS LOG

April 16 1968 R. L. Carpenter Marshall
 date well completed firm name county well located

LANDOWNER: Robert H. Adun

description of formations encountered	from	to
Surface Soil	0	12
Medium Red Sand	12	31
Coarse White Sand	31	50
Med. White Sand	50	79
White Clay	79	95
Med. & Coarse White Sand	95	122
Med. & Fine White Sand	122	150
Med. & Coarse White Sand	150	168

Mt. Pleasant, Miss.
 (mailing address)


WELL LOCATION:
 sec. 9 T 2 N R. 3 E
 2 miles S of Mt. Pleasant
 (distance) (direction) (nearest town)

WELL PURPOSE: Home
 (home, irrigation, municipal, industrial)

WELL COMPLETION DATA:

- (1) diameter (inches) 4
- (2) total depth (feet) 165
- (3) static water level (feet) 81 below top of ground.
- (4) casing Plastic, 159, (material) (depth)
- (5) screen 6 ft., 159 (length) (depth to top)
 2 in., Plastic & Braided (size) (material)
- (6) pump 3/4 (HP) 12 (yield gpm)
 Elee (type power)
- (7) electric log No (yes or no)
- (8) how well bottom plugged Plastic Plug

CODED

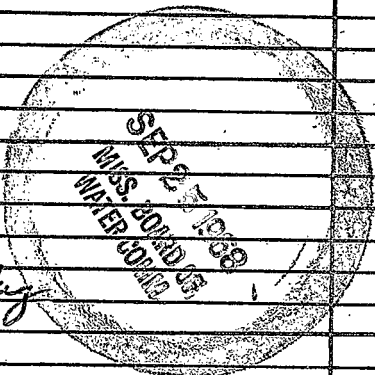


DRILLERS REMARKS:

If well telescopes please sketch and show depths.

GROUND LEVEL

R3 W

f23

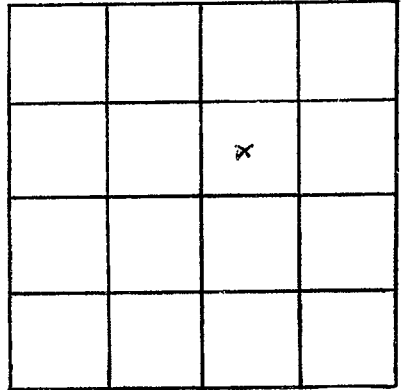

SECTION 9

Please indicate well location X.

ADDITIONAL INFORMATION

If more than one screen, show locations of each on sketch.