

Marshall  
737  
5-18-68

MISSISSIPPI  
BOARD OF WATER COMMISSIONERS  
416 North State Street  
Jackson, Mississippi 39201

**CODED**

WATER WELL DRILLERS LOG

May 18 1968 R. L. Carpenter Marshall  
date well completed firm name county well located

LANDOWNER: Russell T. Houston

description of formations encountered	from	to
---------------------------------------	------	----

Holly Springs,  
Miss.  
(mailing address)

Surface Soil	0	19
--------------	---	----

Med Red Sand	19	74
--------------	----	----

White Coarse sand	74	98
-------------------	----	----

White Clay	98	165
------------	----	-----

White Coarse sand	165	175
-------------------	-----	-----

White Fine sand	175	184
-----------------	-----	-----

Med & Fine White Sand	184	200
-----------------------	-----	-----

White Fine Sand	200	225
-----------------	-----	-----

Med. White Sand	225	250
-----------------	-----	-----

WELL LOCATION:


sec. 31 T 2 N R 3 E  
3 miles north of Red Banks  
(distance) (direction) (nearest town)

WELL PURPOSE: Farm  
(home, irrigation, municipal, industrial)

WELL COMPLETION DATA:

- (1) diameter (inches) 4 in
- (2) total depth (feet) 250
- (3) static water level (feet) 82 below top of ground.
- (4) casing Plastic, 238, (material) (depth)
- (size) if telescope see back.
- (5) screen 12 ft., 238 ft. (length) (depth to top)  
4 in., Plastic & Strand (size) (material)
- (6) pump One 20 (HP) (yield gpm)  
Elec. (type power)
- (7) electric log No (yes or no)  
(organization running log)
- (8) how well bottom plugged Plastic Clay

**CODED**

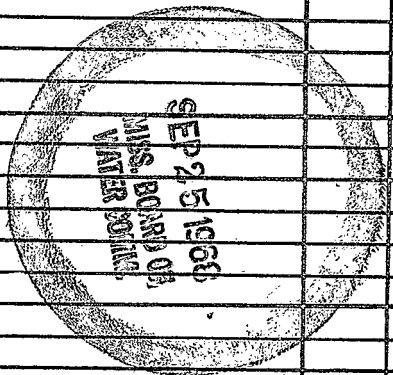


DRILLERS REMARKS:

If well telescopes please sketch and show depths.

GROUND LEVEL

R3W

+25

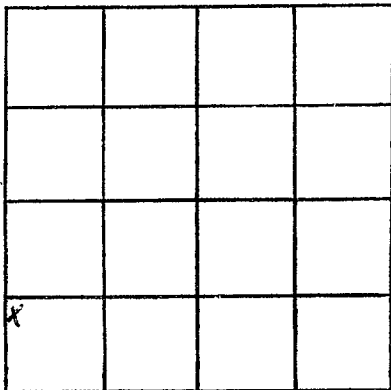

SECTION 31

Please indicate well location X.

ADDITIONAL INFORMATION

If more than one screen, show locations of each on sketch.