

Marshall
 F38
 8-68

MISSISSIPPI
 BOARD OF WATER COMMISSIONERS
 416 North State Street
 Jackson, Mississippi 39201

CODED

WATER WELL DRILLERS LOG

Aug 17 1968 Bumpas well co Marshall
 date well completed firm name county well located

LANDOWNER: Tracy Burdette
Red Bumps - Miss.
R#1
 (mailing address)

description of formations encountered	from	to
	<u>Clay</u> <u>S&S</u>	<u>0</u>
	<u>20</u>	<u>180</u>


WELL LOCATION:
 sec. 20 T. 2 N. R. 3 E.
5 miles S-W of Wipacant
 (distance) (direction) (nearest town)

WELL PURPOSE:
 (home, irrigation, municipal, industrial)

- WELL COMPLETION DATA:
- (1) diameter (inches) 4"
 - (2) total depth (feet) 180
 - (3) static water level (feet) 130 ^{below} _{above} top of ground.
 - (4) casing plastic, 173
 (material) (depth)
4"
 (size) if telescope see back.
 - (5) screen 7 ft, 173
 (length) (depth to top)
4", gravel wall
 (size) (material)
 - (6) pump 3/4 10
 (HP) (yield gpm)
Elect.
 (type power)
 - (7) electric log _____
 (yes or no)

 (organization running log)

CODED

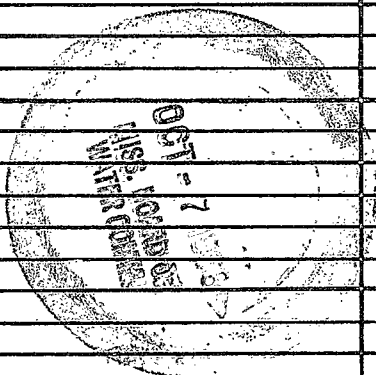


(8) how well bottom plugged 4" Cap

DRILLERS REMARKS:

If well telescopes please sketch and show depths.

GROUND LEVEL

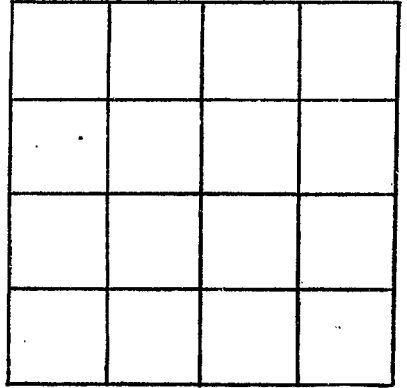

SECTION _____

Please indicate well location X.

ADDITIONAL INFORMATION

If more than one screen, show locations of each on sketch.