

CODED
MISSISSIPPI

BOARD OF WATER COMMISSIONERS
416 North State Street
Jackson, Mississippi 39201

FFB 22 1972

MARSHALL
F40
8-28-71

WATER WELL DRILLERS LOG

Aug. 28 1971 R.L. Carpenter Marshall
date well completed firm name county well located

LANDOWNER: Hon. D. Hughes
Red Bank, Miss.
R.F.D.
(mailing address)

WELL LOCATION:
sec. 8 T 2 N R 3 E
2 1/2 miles Southeast of Atalapha
(distance) (direction) (nearest town)

WELL PURPOSE: Home
(home, irrigation, municipal, industrial)

- WELL COMPLETION DATA:
- (1) diameter (inches) 4
 - (2) total depth (feet) 118
 - (3) static water level (feet) 20 below above top of ground.
 - (4) casing Plastic, 112 ft.
(material) (depth)
 if telescope see back.
(size)
 - (5) screen 6 ft, 112 ft
(length) (depth to top)
4 in, Plastic Sand
(size) (material)
 - (6) pump 3/4, 10
(HP) (yield gpm)
Elec.
(type power)
 - (7) electric log no
(yes or no)

(organization running log)
 - (8) how well bottom plugged Plastic


description of formations encountered	from	to
<u>Surface Soil</u>	<u>0</u>	<u>16</u>
<u>Med Red Sand</u>	<u>16</u>	<u>38</u>
<u>Fire white sand</u>	<u>38</u>	<u>70</u>
<u>White Clay</u>	<u>70</u>	<u>75</u>
<u>White Coarse sand</u>	<u>75</u>	<u>118</u>

CODED

DRILLERS REMARKS:

If well telescopes please sketch and show depths.

GROUND LEVEL

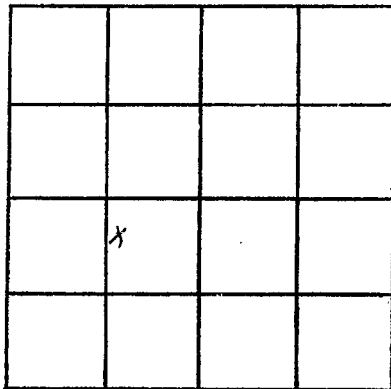

SECTION 8

Please indicate well location X.

ADDITIONAL INFORMATION

If more than one screen,
show locations of each on sketch.