

CODED

MISSISSIPPI

BOARD OF WATER COMMISSIONERS

416 North State Street

Jackson, Mississippi 39201

FEB 22 1972

MARSHALL
F 41
9-22-71

WATER WELL DRILLERS LOG

MISS. BD. OF
WATER COM.

Marshall
county well located

Sept. 22 1971
date well completed

R. L. Capata
firm name

LANDOWNER: *Napelin Martin*
Red Bonny, Miss
R. F. D.
(mailing address)

description of formations encountered	from	to
<i>Surface Sand</i>	<i>0</i>	<i>2.3</i>
<i>yellow fine Red Sand</i>	<i>2.3</i>	<i>4.5</i>
<i>Med white sand</i>	<i>4.5</i>	<i>9.0</i>
<i>white clay</i>	<i>9.0</i>	<i>9.8</i>
<i>White coarse sand</i>	<i>9.8</i>	<i>14.5</i>

WELL LOCATION:
sec. *8* T. *2* N. R. *3* E
3 miles *West of Mt Pleasant*
(distance) (direction) (nearest town)

WELL PURPOSE: *Home*
(home, irrigation, municipal, industrial)


- WELL COMPLETION DATA:
- (1) diameter (inches) *4 in*
 - (2) total depth (feet) *14.5*
 - (3) static water level (feet) *8.5* below above top of ground.
 - (4) casing *Plastic*, *139 ft.*
(material) (depth)
(size) If telescope see back.
 - (5) screen *6 ft*, *139 ft.*
(length) (depth to top)
4 in, *Plastic & Sand*
(size) (material)
 - (6) pump *3/4* *18*
(HP) (yield gpm)
Elec.
(type power)
 - (7) electric log *No*
(yes or no)
(organization running log)
 - (8) how well bottom plugged *Plastic cap*

CODED

DRILLERS REMARKS:

if well telescopes please
sketch and show depths.

GROUND LEVEL

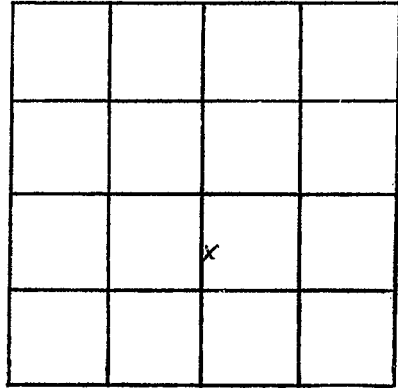

SECTION 8

Please indicate well location X.

ADDITIONAL INFORMATION

If more than one screen,
show locations of each on sketch.