

MARSHALL
F 43
3-15-72

MISSISSIPPI
 BOARD OF WATER COMMISSIONERS
 416 North State Street
 Jackson, Mississippi 39201

WATER WELL DRILLERS LOG

CODED

3-15 1972 Dean Kent Bunch Marshall
 date well completed firm name county well located

LANDOWNER:	description of formations encountered	from	to
<u>A.C. Rogers</u>	<u>clay</u>	<u>0</u>	<u>20</u>
<u>Red Bank, MS 387</u> (mailing address)	<u>sand</u>	<u>20</u>	<u>120</u>
WELL LOCATION:			
sec. <u>20</u> T <u>2</u> N R <u>3</u> E <u>14</u> miles <u>NORTH</u> of <u>Red Bank</u> (distance) (direction) (nearest town)			
WELL PURPOSE: <u>Drinking</u> (home, irrigation, municipal, industrial)			
WELL COMPLETION DATA:			
(1) diameter (inches) <u>4"</u>			
(2) total depth (feet) <u>120 feet</u>			
(3) static water level (feet) <u>80</u> below above top of ground.			
(4) casing <u>pvc</u> <u>120 feet</u> (material) (depth) (size) If telescope see back.			
(5) screen <u>6 ft.</u> <u>11 ft.</u> (length) (depth to top)			
(6) pump <u>4"</u> <u>gravel wall</u> (size) (material)			
(7) pump <u>3/4</u> <u>1/4</u> (HP) (yield gpm)			
(type power)			
(7) electric log <u>elect</u> (yes or no)			
(organization running log)			
(8) how well bottom plugged <u>4' clog</u>			
DRILLERS REMARKS:			


CODED

APR 7 1972

MISS. Bd. OF WATER COMMISSIONERS

If well telescopes please sketch and show depths.

GROUND LEVEL

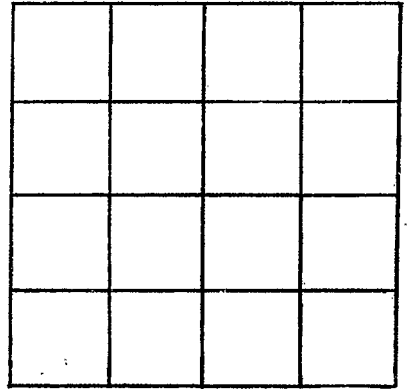

SECTION _____

Please indicate well location X.

ADDITIONAL INFORMATION

If more than one screen,
show locations of each on sketch.