

MARSHALL
F 45
5-22-72

MISSISSIPPI
 BOARD OF WATER COMMISSIONERS
 416 North State Street
 Jackson, Mississippi 39201

CODED

WATER WELL DRILLERS LOG

5-22-72 1972 Dean Hart Drilling Co. Marshall
 date well completed firm name county well located

LANDOWNER:

Walter E. Quillock

description of formations encountered

clay

from 0 to 20

Holly Springs, Miss.
 (mailing address)

Soil

20 120

WELL LOCATION:

sec. 29 T. 2 N. R. 3 E.
13 miles North of Holly Springs
 (distance) (direction) (nearest town)

WELL PURPOSE: Drinking
 (home, irrigation, municipal, industrial)

WELL COMPLETION DATA:

- (1) diameter (inches) 4"
- (2) total depth (feet) 120 feet
- (3) static water level (feet) 40 below above top of ground.
- (4) casing PVC 120 feet
 (material) (depth)

_____ if telescope see back.
 (size)

- (5) screen 7 1/2' 113 feet
 (length) (depth to top)

4" gravel wall
 (size) (material)

- (6) pump 3/4 14
 (HP) (yield gpm)

_____ (type power)

- (7) electric log Elect
 (yes or no)

_____ (organization running log)

- (8) how well bottom plugged 4" Cap.

CODED


JUN 10 1972

DRILLERS REMARKS:

MISS. BD. OF
 WATER COMMISSIONERS

If well telescopes please sketch and show depths.

GROUND LEVEL

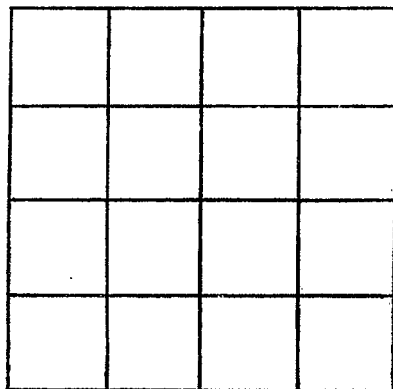

SECTION _____

Please indicate well location X.

ADDITIONAL INFORMATION

If more than one screen,
show locations of each on sketch.