

MARSHALL
F46
5-26-72

MISSISSIPPI
 BOARD OF WATER COMMISSIONERS
 416 North State Street
 Jackson, Mississippi 39201

CODED

WATER WELL DRILLERS LOG

5-26 1972 Robert L. L. Jones Marshall
 date well completed firm name county well located

LANDOWNER: Celia Jones
Holly Spring
Miss
 (mailing address)

description of formations encountered	from	to
<u>Red clay & sand</u>	<u>0</u>	<u>30</u>
<u>" sand</u>	<u>30</u>	<u>135</u>
<u>u. n. white sand</u>	<u>135</u>	<u>165</u>
<u>" "</u>	<u>165</u>	<u>185</u>

WELL LOCATION:
 sec. 26 T 2 N R 3 E
 (distance) (direction) (nearest town)

WELL PURPOSE:
 (home, irrigation, municipal, industrial)

- WELL COMPLETION DATA:
- (1) diameter (inches) 4
 - (2) total depth (feet) 184
 - (3) static water level (feet) 135 below above top of ground.
 - (4) casing plastic, 176
 (material) (depth)
4" if telescope see back.
 (size)
 - (5) screen 8', 176
 (length) (depth to top)
4, gravel pack
 (size) (material)
 - (6) pump 3/4, 10
 (HP) (yield gpm)
Electric
 (type power)
 - (7) electric log ✓
 (yes or no)
 (organization running log)
 - (8) how well bottom plugged plastic cap

CODED


JUN 29 1972

DRILLERS REMARKS:

MISSISSIPPI BOARD OF WATER COMMISSIONERS

If well telescopes please sketch and show depths.

GROUND LEVEL

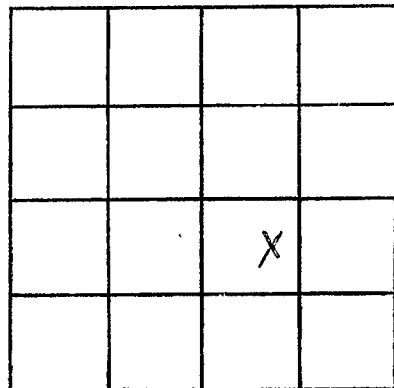

SECTION 26

Please indicate well location X.

ADDITIONAL INFORMATION

If more than one screen,
show locations of each on sketch.