

MARSHALL
F 49
12-19-72

MISSISSIPPI
 BOARD OF WATER COMMISSIONERS
 416 North State Street
 Jackson, Mississippi 39201

CODED

WATER WELL DRILLERS LOG

12-19-72 date well completed Atkinson & Frost firm name Marshall county well located

LANDOWNER:

John Snow
1st Pleasant Mine
 (mailing address)

description of formations encountered

from to

Red Clay	0	5
SAND	5	105

WELL LOCATION:

sec. 2 T. 2 N. R. 3 E
5 1/2 miles 3 of 1st Pleasant
 (distance) (direction) (nearest town)

WELL PURPOSE:

(home, irrigation, municipal, industrial)

WELL COMPLETION DATA:

- (1) diameter (inches) 4 1/2
- (2) total depth (feet) 105
- (3) static water level (feet) 18 below above top of ground
- (4) casing POC 100
 (material) (depth)
 (size) If telescope see back.
- (5) screen 1.00 105
 (length) (depth to top)
 (size) (material)
- (6) pump 1/2 7
 (HP) (yield gpm)
Elec
 (type power)
- (7) electric log NO
 (yes or no)

(organization running log)


(8) how well bottom plugged CAP

DRILLERS REMARKS:

JAN 11 1973

If well telescopes please sketch and show depths.

GROUND LEVEL

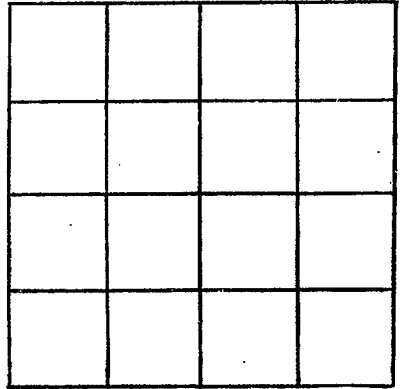

SECTION _____

Please indicate well location X.

ADDITIONAL INFORMATION

If more than one screen, show locations of each on sketch.