

MARSHALL
F50
3-73

MISSISSIPPI
 BOARD OF WATER COMMISSIONERS
 416 North State Street
 Jackson, Mississippi 39201

CODED

WATER WELL DRILLERS LOG

19 Atkinson & Frost Marshall
 date well completed firm name county well located

LANDOWNER:
Matthail Reed
Red Banks Miss
 (mailing address)

description of formations encountered	from	to
<u>Red Clay</u>	<u>0</u>	<u>15</u>
<u>Red sand</u>	<u>15</u>	<u>75</u>
<u>white clay</u>	<u>75</u>	<u>90</u>
<u>white sand</u>	<u>90</u>	<u>140</u>

WELL LOCATION:
 sec. 1 T. 2 N. R. 3 E.
1/2 miles NE of Red Banks
 (distance) (direction) (nearest town)

WELL PURPOSE:
 (home, irrigation, municipal, industrial)

- WELL COMPLETION DATA:
- (1) diameter (inches) 4"
 - (2) total depth (feet) 140
 - (3) static water level (feet) 20 below above top of ground.
 - (4) casing PVC, 130
 (material) (depth)
 (size) if telescope see back.
 - (5) screen 10, 130
 (length) (depth to top)
4", PVC
 (size) (material)
 - (6) pump 3/4, 10
 (HP) (yield gpm)
elec.
 (type power)
 - (7) electric log NO
 (yes or no)
 (organization running log)
 - (8) how well bottom plugged CAP


CODED

DRILLERS REMARKS:

ADP
 1973

If well telescopes please sketch and show depths.

GROUND LEVEL

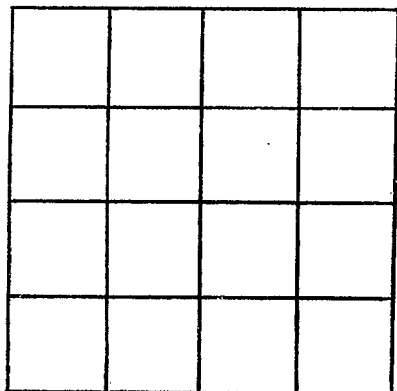

SECTION _____

Please indicate well location X.

ADDITIONAL INFORMATION

If more than one screen,
show locations of each on sketch.