

MARSHALL

F 52

7-23-13

MISSISSIPPI BOARD OF WATER COMMISSIONERS
416 North State Street
Jackson, Mississippi 39201

CODED

WATER WELL DRILLERS LOG


6-29 1973 Desmet-Burgin well Marshall
date well completed firm name county well located

LANDOWNER:	description of formations encountered	from	to
<u>Phillip R Teal</u> <u>Red Banks, At 1, Miss.</u> (mailing address)			
	<u>Sand</u>	<u>30</u>	<u>180</u>
WELL LOCATION:			
sec. <u>9</u> T. <u>2</u> N. R. <u>3</u> E. <u>W</u>			
<u>2</u> miles <u>South, int. plane</u> (distance) (direction) (nearest town)			
WELL PURPOSE: <u>Drinking</u> (home, irrigation, municipal, industrial)			
WELL COMPLETION DATA:			
(1) diameter (inches) <u>4"</u>			
(2) total depth (feet) <u>180 feet</u>			
(3) static water level (feet) <u>120</u> below above top of ground.			
(4) casing <u>PVC</u> <u>180 feet</u> (material) (depth)			
<u> </u> if telescope see back. (size)			
(5) screen <u>7ft.</u> <u>173 feet</u> (length) (depth to top)			
<u>4"</u> <u>gravel</u> (size) (material)			
(6) pump <u>3/4</u> <u>14</u> (HP) (yield gpm)			
<u> </u> (type power)			
(7) electric log <u>Elect.</u> (yes or no)			
<u> </u> (organization running log)			
(8) how well bottom plugged <u>4" cof.</u>			
DRILLERS REMARKS:			
<u>JUL 10 1973</u>			

CODED

If well telescopes please sketch and show depths.

GROUND LEVEL

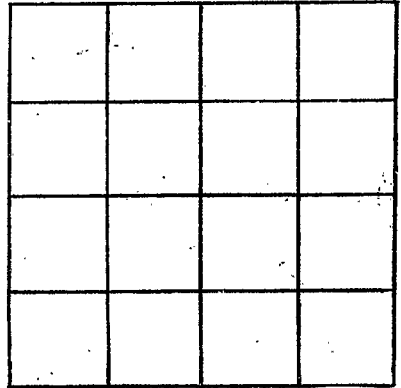

SECTION _____

Please indicate well location X.

ADDITIONAL INFORMATION

If more than one screen,
show locations of each on sketch.