

MARSHALL

F53

2-21-73

MISSISSIPPI BOARD OF WATER COMMISSIONERS
416 North State Street
Jackson, Mississippi 39201

CODED

WATER WELL DRILLERS LOG

Feb. 21 1973
date well completed

R. L. Carpenter
firm name

Marshall
county well located

LANDOWNER: Clifton Anderson
Mt. Pleasant, Miss
RFD
(mailing address)

description of formations encountered

from

to

surface soil	0	18
med. Red. Soil	18	45
med. fine white sand	45	96
white clay	96	125
med. white sand	125	153
white coarse sand	153	170

WELL LOCATION:

sec. 9 T. 2 N. R. 3 E.
2 1/2 miles South of Mt. Pleasant
(distance) (direction) (nearest town)

WELL PURPOSE: Home
(home, irrigation, municipal, industrial)

WELL COMPLETION DATA:

- (1) diameter (inches) 4
- (2) total depth (feet) 150
- (3) static water level (feet) 168 below above top of ground.
- (4) casing plastic, 164 ft.
(material) (depth)
(size) if telescope see back.
- (5) screen 6 ft., 164 ft.
(length) (depth to top)
1/2 in. Plaster sand
(size) (material)
- (6) pump 3/4 10
(HP) (yield gpm)
Elec.
(type power)
- (7) electric log no.
(yes or no)


CODED

DRILLERS REMARKS:

JUL 30 1973

If well telescopes please sketch and show depths.

GROUND LEVEL

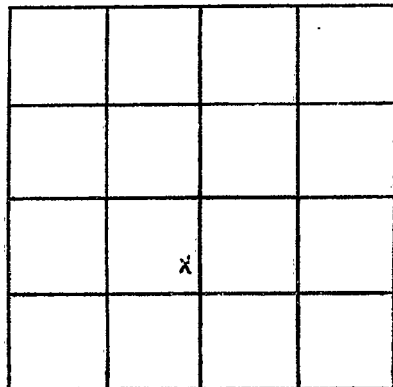

SECTION 9

Please indicate well location X.

ADDITIONAL INFORMATION

If more than one screen,
show locations of each on sketch.