

Marshall
F58
8-15-73

MISSISSIPPI
 BOARD OF WATER COMMISSIONERS
 416 North State Street
 Jackson, Mississippi 39201

CODED

WATER WELL DRILLERS LOG

8-15 1973 *Prentis A. Lewis* *Marshall*
 date well completed firm name county well located

LANDOWNER:
Prentis A. Lewis
Mt. Pleasant Miss.
 (mailing address)

WELL LOCATION:
 sec. 9 T. 2 N. R. 3 E.
3 1/2 miles South of Mt. Pleasant
 (distance) (direction) (nearest town)

WELL PURPOSE: Dwelling
 (home, irrigation, municipal, industrial)

- WELL COMPLETION DATA:
- (1) diameter (inches) 4"
 - (2) total depth (feet) 200 feet
 - (3) static water level (feet) 100 below above top of ground.
 - (4) casing prc 200 feet
 (material) (depth)
 (size) if telescope see back.
 - (5) screen 2 ft. 193 feet
 (length) (depth to top)
4" gravel
 (size) (material)
 - (6) pump 3/4 14
 (HP) (yield gpm)
 (type power)
 - (7) electric log elect.
 (yes or no)
 (organization running log)
 - (8) how well bottom plugged 4" cof.

description of formations encountered	from	to
	<i>Clay</i>	<i>0</i>
<i>Sand</i>	<i>30</i>	<i>140</i>
<i>clay</i>	<i>140</i>	<i>145</i>
<i>Sand</i>	<i>145</i>	<i>200</i>

CODED


SEP 11 1973

DRILLERS REMARKS:

MISS. BD. OF
 WATER COMMISSIONERS

If well telescopes please sketch and show depths.

GROUND LEVEL

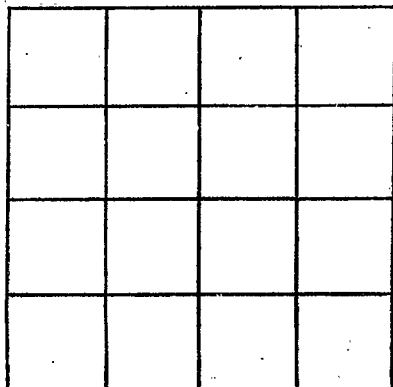

SECTION _____

Please indicate well location X.

ADDITIONAL INFORMATION

If more than one screen, show locations of each on sketch.