

**Marshall**  
**F59**  
**8-31-73**

MISSISSIPPI  
 BOARD OF WATER COMMISSIONERS  
 416 North State Street  
 Jackson, Mississippi 39201

**CODED**

WATER WELL DRILLERS LOG

8-31 1973 Dean Kent Bumpas well Marshall  
 date well completed firm name county well located

LANDOWNER:  
John Cote w/ol  
Holly Springs Pt 2  
 (mailing address)

description of formations encountered	from	to
<u>Clay</u>	<u>0</u>	<u>20</u>
<u>Sand</u>	<u>20</u>	<u>150</u>

WELL LOCATION:  
 sec. 26 T. 2 N. R. 3 E.  
1.2 miles North of Keokuk  
 (distance) (direction) (nearest town)

WELL PURPOSE: Drinking  
 (home, irrigation, municipal, industrial)

- WELL COMPLETION DATA:
- (1) diameter (inches) 4"
  - (2) total depth (feet) 150 feet
  - (3) static water level (feet) 70 <sup>below</sup> / <sub>above</sub> top of ground.
  - (4) casing PVC 150 feet  
 (material) (depth)  
 (size) If telescope see back.
  - (5) screen 24" 143 feet  
 (length) (depth to top)  
4" gravel  
 (size) (material)
  - (6) pump 3/4 14  
 (HP) (yield/gpm)  
 (type power)
  - (7) electric log Elef.  
 (yes or no)  
 (organization running log)
  - (8) how well bottom plugged 4" cap


**CODED**

DRILLERS REMARKS:

SEP 11 1973  
 MISS. BD. OF WATER COMMISSIONERS

If well telescopes please sketch and show depths.

GROUND LEVEL

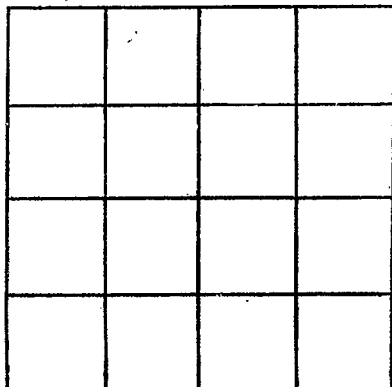

SECTION \_\_\_\_\_

Please indicate well location X.

ADDITIONAL INFORMATION

If more than one screen,  
show locations of each on sketch.