

Marshall

F 60

8-31-73

MISSISSIPPI
 BOARD OF WATER COMMISSIONERS
 416 North State Street
 Jackson, Mississippi 39201

CODED

WATER WELL DRILLERS LOG

8-31

1973

Demetrius Buford Marshall
firm name county well located

LANDOWNER:

Matthew Catwood
pt. 1, Lamar Miss.
(mailing address)

description of formations encountered

from to

Clay

0 30

Sand

30 140

Clay

140 150

Sand

150 170

WELL LOCATION:

sec. 12 T. 2 N. R. 3 E.
1 1/2 miles *South* of *Clayton*
(distance) (direction) (nearest town)

WELL PURPOSE: *Drinking*
(home, irrigation, municipal, industrial)

CODED

WELL COMPLETION DATA:

- (1) diameter (inches) 4
- (2) total depth (feet) 170 feet
- (3) static water level (feet) 140 below above top of ground.
- (4) casing PVC 170 feet
(material) (depth)

(size) if telescope see back.

- (5) screen 7 ft. 163 feet
(length) (depth to top)
- 4" gravel wall
(size) (material)

- (6) pump 3/4 14
(HP) (yield/gpm)

(type power)

- (7) electric log elect.
(yes or no)

(organization running log)


- (8) how well bottom plugged 7" cap.

SEP 11 1973

DRILLERS REMARKS:

If well telescopes please sketch and show depths.

GROUND LEVEL

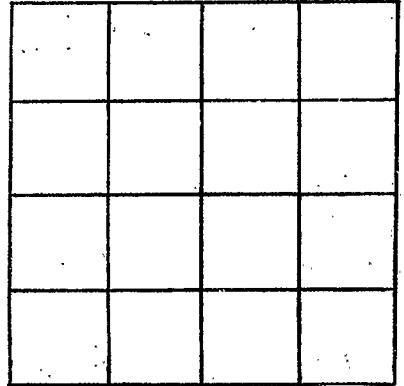

SECTION _____

Please indicate well location X.

ADDITIONAL INFORMATION

If more than one screen,
show locations of each on sketch.