

MARSHALL

F 61

9-7-73

MISSISSIPPI BOARD OF WATER COMMISSIONERS
416 North State Street
Jackson, Mississippi 39201

CODED

WATER WELL DRILLERS LOG

9-7
date well completed

1973 Pearl Kent Surface
firm name

Marshall
county well located

LANDOWNER:

Robert E. Mathes

Int. Pleasant, Miss.
(mailing address)

description of formations encountered

clay

from 0 to 20

sand

20 60

clay

60 65

sand

65 180

WELL LOCATION:

sec. 9 T. 2 N. R. 3 E.
12 miles North of Spring
(distance) (direction) (nearest town)

WELL PURPOSE: Drinking
(home, irrigation, municipal, industrial)

WELL COMPLETION DATA:

- (1) diameter (inches) 4"
- (2) total depth (feet) 180 feet
- (3) static water level (feet) 100 below top of ground.
- (4) casing PVC 180 feet (material) (depth)

CODED

- (5) screen 7 ft. 173 feet (length) (depth to top)
- 4" gravel work (size) (material)

- (6) pump 3/4 HP 14 (yield gpm)

- (7) electric log elect (yes or no)


- (8) how well bottom plugged 4" conf.

OCT 9 1973

DRILLERS REMARKS:

If well telescopes please sketch and show depths.

GROUND LEVEL

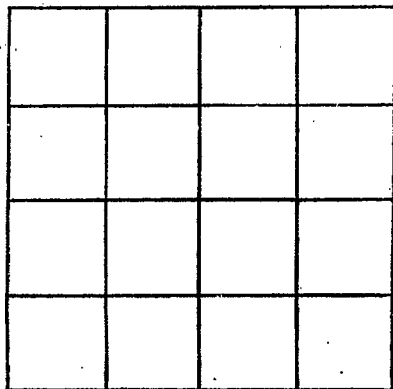

SECTION _____

Please indicate well location X.

ADDITIONAL INFORMATION

If more than one screen, show locations of each on sketch.