

MARSHALL

F 62

9-5-73

MISSISSIPPI BOARD OF WATER COMMISSIONERS  
416 North State Street  
Jackson, Mississippi 39201

CODED

WATER WELL DRILLERS LOG

9-5 date well completed  
1973 Dean Kent Humphreys firm name  
Marshall county well located

LANDOWNER:  
Tony Higgins  
Holly Springs, Miss.  
(mailing address)

description of formations encountered	from	to
	clay	0
Sand	10	78

WELL LOCATION:  
sec. 27 T. 2 N. R. 3 E  
1.2 miles North of Holly Springs  
(distance) (direction) (nearest town)

WELL PURPOSE: Drinking  
(home, irrigation, municipal, industrial)

- WELL COMPLETION DATA:
- (1) diameter (inches) 4"
  - (2) total depth (feet) 78 feet
  - (3) static water level (feet) 12 below above top of ground.
  - (4) casing PVC 78 feet  
(material) (depth)  
       if telescope see back.  
(size)
  - (5) screen 7 ft. 71  
(length) (depth to top)  
4" gravel  
(size) (material)
  - (6) pump 3/4 14  
(HP) (yield/gpm)  
        
(type power)
  - (7) electric log Elect.  
(yes or no)  
        
(organization running log)
  - (8) how well bottom plugged 4" cap.


CODED

DRILLERS REMARKS:

OCT 9 1973

If well telescopes please sketch and show depths.

GROUND LEVEL

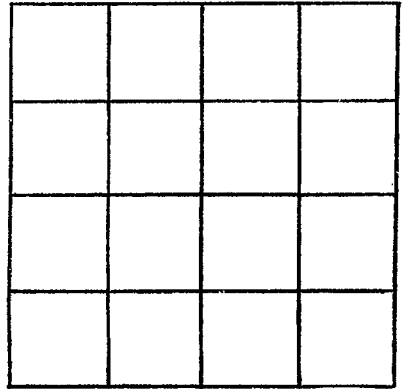

SECTION \_\_\_\_\_

Please indicate well location X.

ADDITIONAL INFORMATION

If more than one screen,  
show locations of each on sketch.