

MARSHALL

F-64

10-5-73

MISSISSIPPI BOARD OF WATER COMMISSIONERS
416 North State Street
Jackson, Mississippi 39201

CODED

WATER WELL DRILLERS LOG

10-5-73
date well completed

Dean Kent Bumpstead
firm name

Marshall
county well located

LANDOWNER:

Mrs. J. C. Brasher
Rt 1, Red Banks, Miss.
(mailing address)

description of formations encountered

clay

from

to

0 30

sand

30 110

WELL LOCATION:

sec. 18 T 2 N R 3 E
5 miles South of Mt. Pleasant
(distance) (direction) (nearest town)

WELL PURPOSE: Domestic
(home, irrigation, municipal, industrial)

WELL COMPLETION DATA:

- (1) diameter (inches) 4"
- (2) total depth (feet) 110 feet
- (3) static water level (feet) 90 ^{below} ~~above~~ top of ground.
- (4) casing PVC 110 feet
(material) (depth)

CODED

 if telescope see back.
(size)

- (5) screen 7 ft. 103 feet
(length) (depth to top)

4" Drumwell
(size) (material)

- (6) pump 3/4 10
(HP) (yield gpm)

(type power)

- (7) electric log elect.
(yes or no)

(organization running log)

- (8) how well bottom plugged 4" col.


DRILLERS REMARKS:

NOV 9 1973

MISSISSIPPI
WATER WELL

If well telescopes please sketch and show depths.

GROUND LEVEL

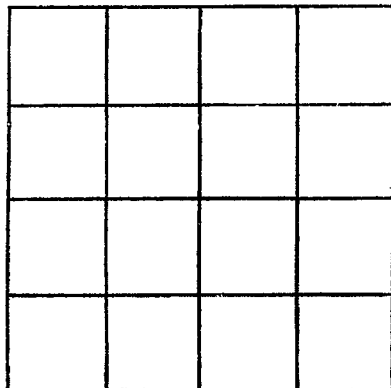

SECTION _____

Please indicate well location X.

ADDITIONAL INFORMATION

If more than one screen,
show locations of each on sketch.